


DX 78-1

Dickinson KANSAS

Section 26 Township 16 Range 1E

Well No. 1 M. Cowman

Company Slusser Drlg.

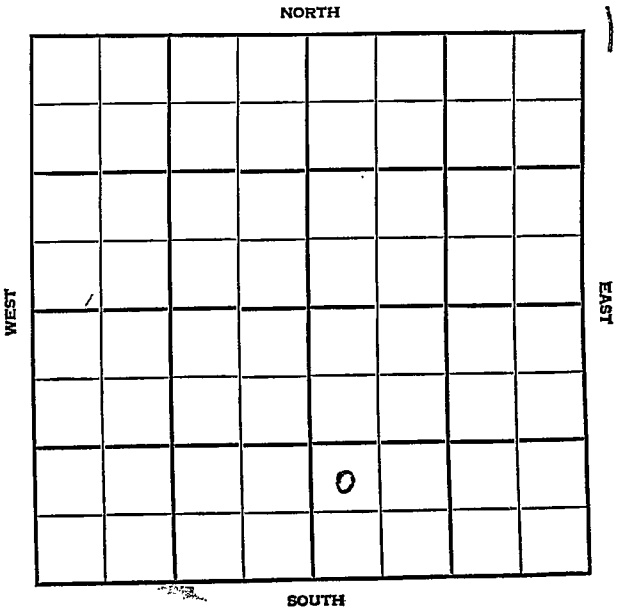

Dickinson KANSAS

SEC.	TWP.	R.
26	16	4 E

WELL NO. # 1 M. Cowman FARM

COMPANY Slusser Drlg.

CONTRACTOR Co. tools


Lost Springs Pool

_____ Ft. from N. Line

990 _____ Ft. from S. Line

_____ Ft. from E. Line

330 _____ Ft. from W. Line

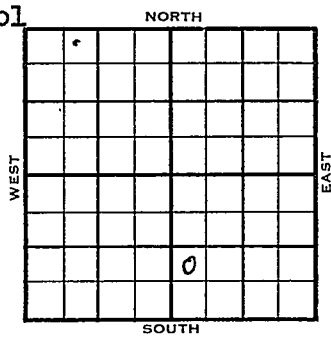

NW SW SE

1954	ELEVATION 1446'	REPORT
------	-----------------	--------

10/13 Spud 10-8-54
8" @ 106
Drlg. 840'

11/23 Spud 10-8-54
Oil Well
TD 2345'
8" @ 106'
Miss 2317'
TD 2323'
5" @ 2323
DD 2345'
Miss 2324'
4 bopd. frac. S/ 10 boph wtr.
Comp 25 bopd.

COMPLETED

