


DX 78-1

Section 26 Township 16 Range 4E

Well No. #2 M. Cowan
~~McGowan~~

Company Slusser Drlg.

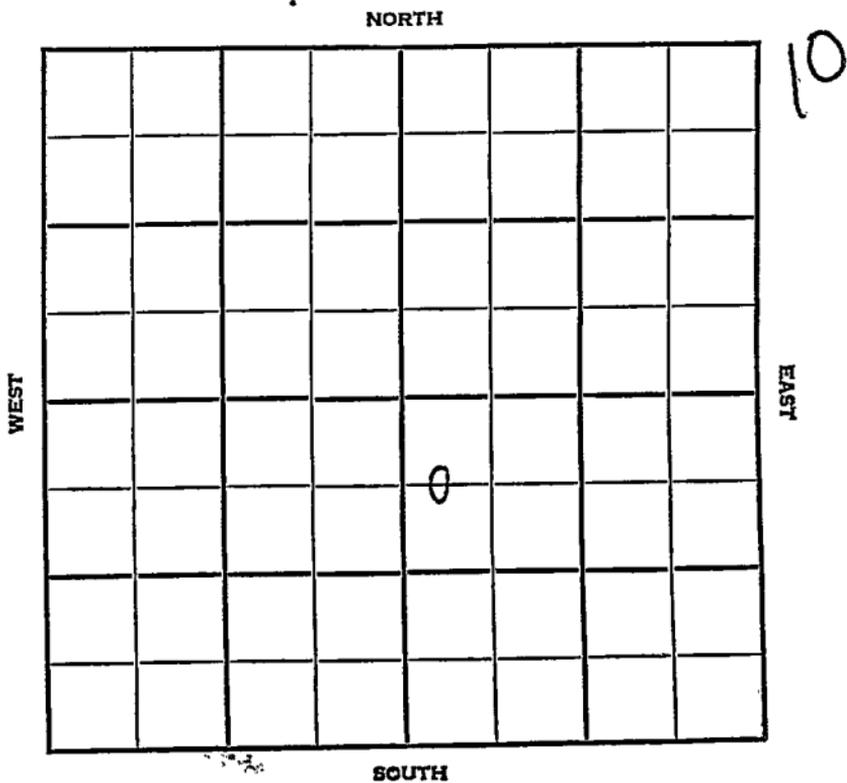

SEC.	TWP.	R.
26	16	1E
WELL NO. #2 <u>M. Cowman</u> <u>McGowan</u>		
COMPANY		FARM

Slusser Drlg.

CONTRACTOR

Co. Tools.


Lost Springs Pool

660 _____ Ft. from N. Line

_____ Ft. from S. Line

_____ Ft. from E. Line

330 _____ Ft. from W. Line

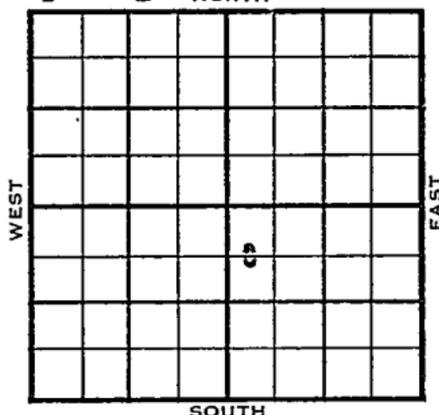C W $\frac{1}{2}$ NW SE

	ELEVATION	REPORT
1955		
2/23		Spud 2-21-55 Drlg. 60'
3/23		Spud 2-21-55, Oil Well, TD 2345, 8" @ 106, Miss 2310, TD 2315, 5" @ 2315, DD 2345 B/ 15 GOPH sd-frac Comp 25 BOPD 50 to 75% wtr COMPLETED

County Dickinson State Kansas

Sec. 26 (Blk. Twp.) 16 (Sur. Rge.) 4E Map No.

Operator Slusser Drlg.

Well No. 2 Farm M. Cowman

Elev. Location C W¹/₂ NW SE

COMPLETE

660 Ft. From N Line SE

330 Ft. From W Line Quarter

1st. Report

Completion MAR 23 1955

Remarks Lost Springs Pool

Co. tools

Spudding Date 2-21-55

Drlg. Data Oil well TD 2345

8" @ 106 Miss. 2310 TD 2315

5" @ 2315 DD 2345 B/ 15 goph

sd-frac : Comp. 25 bopd 50 to 75% wtr.

FABEN GILSTRAD

SCOUT TICKET

Kansas

DX-201

SEC.	TWP.	R.
26	16	4E

WELL NO. 2 M. Cowman FARM

COMPANY

Slusser Drlg.

CONTRACTOR

CORRECTION


C W $\frac{1}{2}$ NW SE

660 FT. FROM N. LINE

_____ FT. FROM S. LINE

_____ FT. FORM E. LINE

330 FT. FROM W. LINE

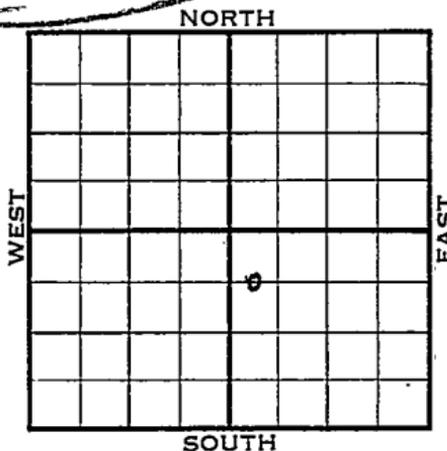

Dickinson County

- LOCATION
 - RIG UP
- DRILLING AND REMARKS:

Reported
#2 McCowan

RECORD	CASED IN., FT.
	SAND
	GAS
	OIL
PRODUCTION	TOTAL DEPTH
	1ST 24 HRS. NAT.
	1ST 24 HRS. AFTER SHOT
	GAS CU. FT.
	ABANDONED

DATE MAR 23 1955 SCOUT FABEN GILSTRAP

