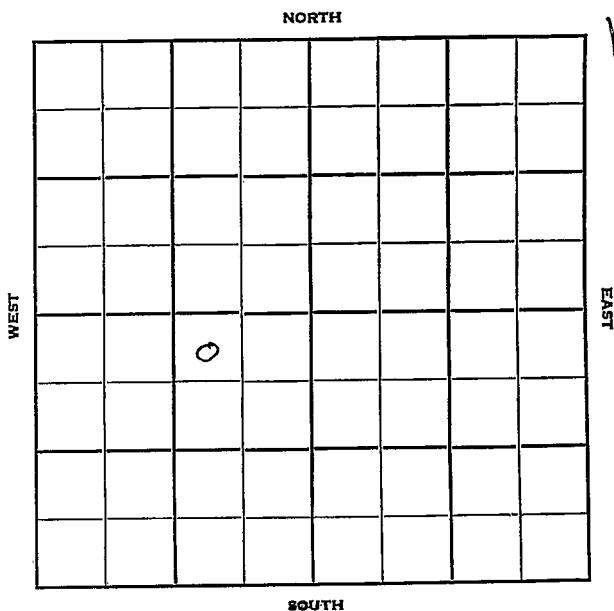


Section 26 Township 16 Range 4EWell No. #2 SchlesenerCompany Slusser Drlg.

Sec. 26 Twp. 16 R. 4E

Well No. #2 Schlesener Farm

Slusser Drlg. Company

Slusser Contractor


330 Ft. from N. Line

Ft. from S. Line

990 Ft. from E. Line

Ft. from W. Line

NW NE SW

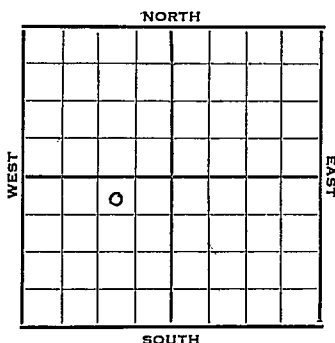

1952

Elev. 1429 REPORT

8/20 Spud 8-18-52
8" @ 105'

9/10 Spud 8-18-52 Oil Well TD 2346
8" @105 KC 1710 Chat 2287
TD 2288 5" @ 2288 DD 2346
Comp. 30 bopd

COMPLETED

County Dickinson State Kansas

Sec. **26** (Blk.) **16** (Sur.) **4E** Map No.

Operator **Slusser Drig.**

Well No. **2** Farm **Schlesener**

Elev.	Location	NW	NE	SW
-------	----------	----	----	----

330 Ft. From N Line SW

990	Ft. From	E	Line	Quarter
-----	----------	---	------	---------

1st. Report **AUG 20 1952**

Completion

Remarks

Slusser - Contr.

Spudding Date **8-18-52**

Drlg. Data

8th @ 105

J. G. McGEHEE

J. G. McGEHEE