


FORM 51 25M 3-49 PETROL Dickinson

Section 26 Township 16 Range 1E

Well No. #3 Schlesener

Company Slusser Drlg.

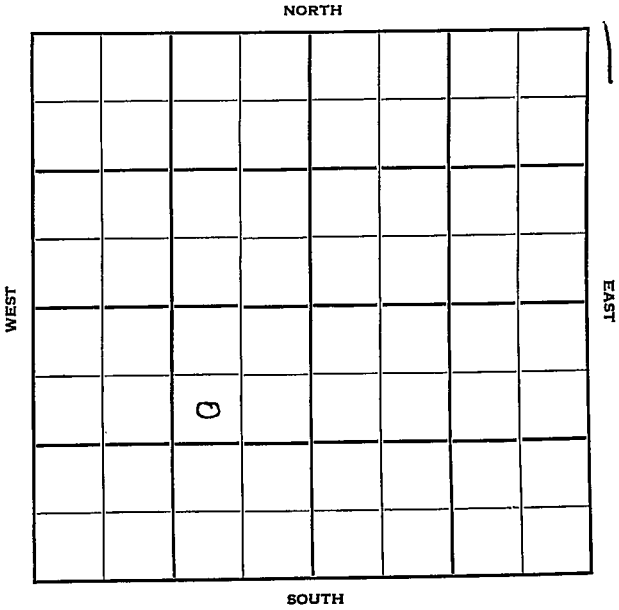

Dickinson

KANSAS

Sec. 26 Twp. 16 R. 4E

Well No. #3 Schlesener Farm

Slusser Drlg. Company

Slusser Drlg. Contractor

Lost Springs Pool


990 Ft. from N. Line

\_\_\_\_\_ Ft. from S. Line

990 Ft. from E. Line

\_\_\_\_\_ Ft. from W. Line

SW  $\frac{1}{4}$  SW NE SW

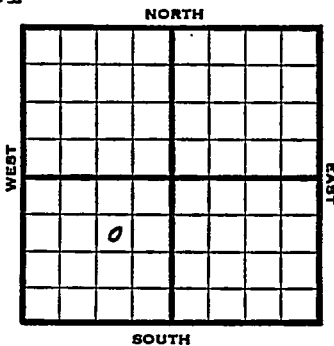

1952

Elev. -

REPORT

11/5 Spud 10-30-52  
8" @ 80'  
Drlg. 1915'

12/10 Spud 10-30-52  
Oil well TD 2343' 8" @ 80  
Miss 2281' TD 2286 5" @ 2285  
DD 2317 DD 2343 oil-frac.  
Comp. 10 BOPD 15 BW

**COMPLETED**



