

KANSAS

Section 26 Township 16 Range 4EWell No. 5 ~~117~~ SchlesnerCompany Hutchinson Oil & Gas
SLUSSER DRILL.

NORTH

WEST

EAST

SOUTH

14

0

KANSAS

Dickinson

O.W.W.O.

Sec. 26 Twp. 16 R. 4-E

Well No. #5 #1 Schlesner Farm

Slusser Drlg.
Hutchinson Oil & Gas

Company

Lost Spring


Ft. from N. Line

990' Ft. from S. Line

330' Ft. from E. Line

Ft. from W. Line

NE SE SW

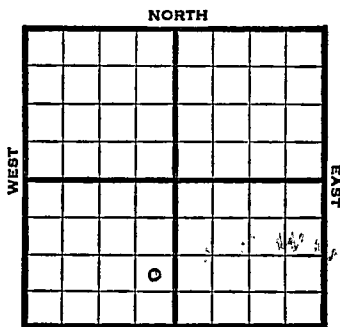

SOUTH
Slusser - CONTR.

1947

Elev. 1422' REPORT

11/25

8" @ 112'
Drlg. 1800'

12/3

Mississippi, 2275'
TD 2277'
5" @ 2277'

12/10

Miss. 2275'
5" @ 2277'
Total Depth 2374'

ABANDONED

1954

8/4

Miss 2275'
OTD 2334'
5" @ 2277'
RUR

9/22

Oil well TD 2334 Miss. 2275
OTD 2334 5" @ 2277 DD 2321
S/4 BOPH frac. Comp. 20 BOPD 5 BW

COMPLETED

O.W.W.O.

Map No. _____ Sec. 26 Twp. 16 R. 4E

Well No. 1 Schlesner

Hutchinson Oil & Gas Company

FIRST REPORT Contractor

NE SE SW


SECTION PLAT

_____ Ft. from N. Line

990 Ft. from S. Line

330 Ft. from E. Line

_____ Ft. from W. Line

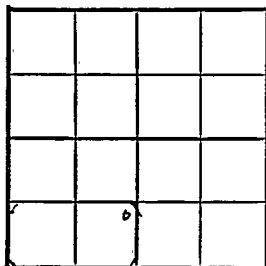

Dickinson County

Location _____

Rig up _____

Drilling and Remarks:

8" @ 112

drlg. 1800

RECORD

Cased _____ in., _____ ft.

Sand _____

Gas _____

Oil _____

Total Depth _____

PRODUCTION

1st 24 hrs. Nat. _____

1st 24 hrs. after shot _____

Gas _____ Cu. Ft.

Dry Hole _____

Abandoned _____

Date

NOV 25 1947 19

S. J. LEWIS Scout

Map No. 26 Sec. 26 Twp. 16 R. 4E

Well No. 1 Schlesner

Hutchinson Oil & Gas Company

ABANDONED

Contractor

NE SE SW

E 1/4 22
SECTION PLAT

 Ft. from N. Line

990 Ft. from S. Line

330 Ft. from E. Line

 Ft. from W. Line

Dickinson County

Location

Rig up

Drilling and Remarks:

Miss 2275

5" @ 2277

RECORD

Cased in., ft.

Sand

Gas

Oil

Total Depth 2834

PRODUCTION

1st 24 hrs. Nat.

1st 24 hrs. after shot

Gas Cu. Ft.

Dry Hole

Abandoned

Date

DEC 1 0 1947 19

S. J. LEWIS Scout

County Dickinson State O.W.W.O. Kansas

Sec. **26** (Blk. **16** (Sur. **4E** Twp.) Rge.) Map No.

Operator **Slusser Drig.**

Well No. **1** Farm **Schlesener**

Elev.	Location	NE	SE	SW
-------	----------	----	----	----

FIRST REPORT

990 Ft. From S Line SW

330 Ft. From E Line Quarter

1st. Report **AUG- 4 1954**

Completion O.W.W.O.

Remarks **OWHO**

Slusser - Contr.

Spudding Date _____

Drig. Data

Miss. 2275 OTD 2334 5" @ 2277

R U R


Map No. _____ Sec. 26 Twp. 16 R. 4EWell No. 5 Schlesener

Slusser Drlg. _____ Company

CORRECTION _____ Contractor

NE SE SW

SECTION PLAT

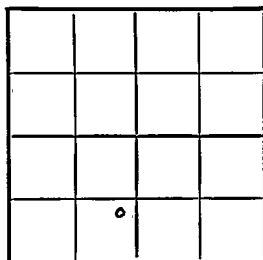

_____ Ft. from N. Line

990 Ft. from S. Line330 Ft. from E. Line

_____ Ft. from W. Line

Dickinson County

Location _____

Rig up _____

Drilling and Remarks:

Reported
#1 Schlesener

RECORD

Cased _____ in., _____ ft.

Sand _____

Gas _____

Oil _____

Total Depth _____

PRODUCTION

1st 24 hrs. Nat. _____

1st 24 hrs. after shot _____

Gas _____ Cu. Ft.

Dry Hole _____

Abandoned _____

Date

AUG 18 1954

FABEN GILSTRAP Scout

FABEN GILSTRAP