


FORM 51 25M 3-49 PETROL

Morris

Section 26 Township 16 Range 5E

Well No. #1 Peterson

Company #d Koester & Joe Morgan et al

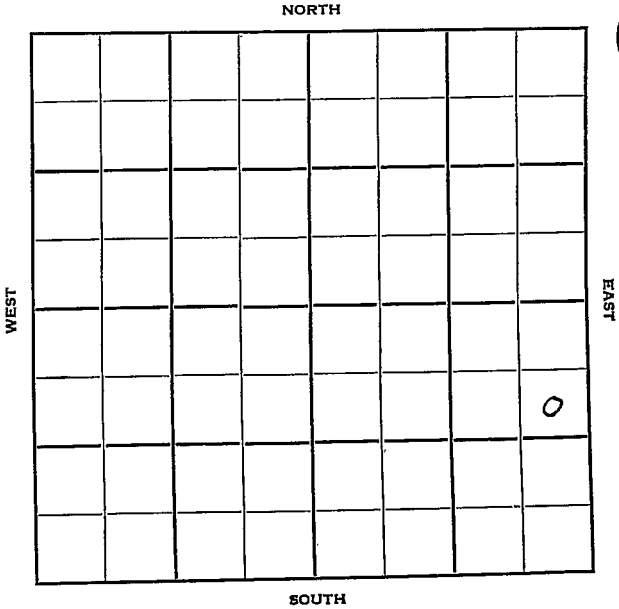

Morris

Sec. 26 Twp. 16 R. 5E

Well No. #1 Peterson Farm

Ed Koester & Joe Mergen et al Company

Mendenhall Drlg. Contractor


990' Ft. from N. Line

Ft. from S. Line

330' Ft. from E. Line

Ft. from W. Line

SE NE SE

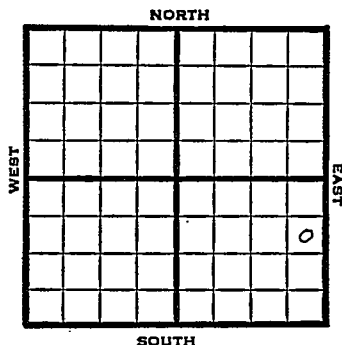

1950

Elev 1480

REPORT

6/21

Location

7/26

10 3/4" @ 139

Miss 2216

7" @ 2217

TD 2268

FU 330' oil

500' wtr

Comp 25 bopd, 50% wtr

Completed

COMPLETED

Kansas

Map No. _____ Sec. 26 Twp. 16 R. 5E

Well No. 1 Peterson

Ed Koester & Joe Mergen et al. Company

Mendenhall Drlg. Contractor

SE NE SE


SECTION PLAT

990 Ft. from N. Line

_____ Ft. from S. Line

330 Ft. from E. Line

_____ Ft. from W. Line

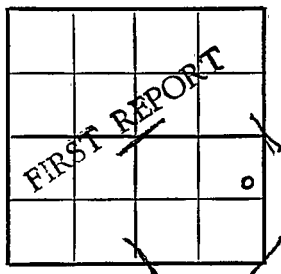

Morris County

Location X

Rig up

Drilling and Remarks:

RECORD

Cased _____ in., _____ ft.

Sand _____

Gas _____

Oil _____

Total Depth _____

PRODUCTION

1st 24 hrs. Nat. _____

1st 24 hrs. after shot _____

Gas _____ Cu. Ft.

Dry Hole _____

Abandoned _____

Date

JUN 21 1950 19 J. E. TYRA Scout

Map No. _____ Sec. 26 Twp. 16 R. 5EWell No. 1 Peterson_____ Ed Koester & Joe Mergen Company

_____ Contractor


SE NE SE

E1. 1480
SECTION PLAT_____ 990 Ft. from N. Line

_____ Ft. from S. Line

_____ 330 Ft. from E. Line

_____ Ft. from W. Line

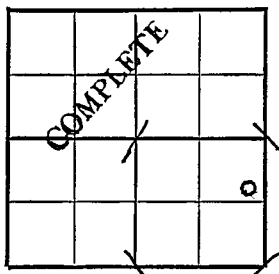_____ Morris County

Location _____

Rig up _____

Drilling and Remarks:

10 3/4" @ 139Miss. 22167" @ 2217TD 2268FU 330' oil
500' waterComp. 25 bopd
50% water

RECORD

Cased _____ in., _____ ft.

Sand _____

Gas _____

Oil _____

Total Depth 2268

PRODUCTION

1st 24 hrs. Nat. _____

1st 24 hrs. after shot _____

Gas _____ Cu. Ft.

Dry Hole _____

Abandoned _____

Date

JUL 26 1950 19J. E. TYRA Scout