


Section 26 Township 16 Range 5E

Well No. #2 Peterson

Company Koester & Mergen

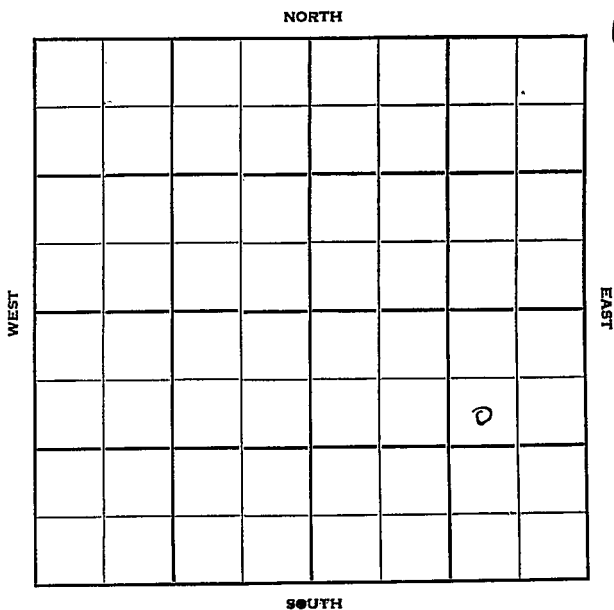

Sec. 26 Twp. _____ R. _____

#2 Peterson

Well No. _____ Farm _____

Koester & Mergen

Company

Mendenhall Drlg.

Contractor


990 Ft. from N. Line

_____ Ft. from S. Line

990 Ft. from E. Line

_____ Ft. from W. Line

SW NE SE

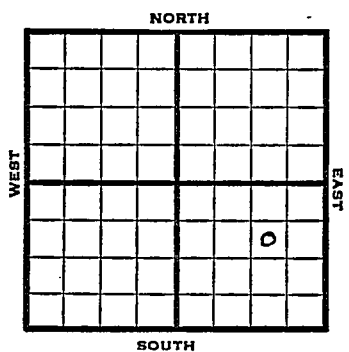

1950 Elev. 1488' REPORT

12/13 Location
1951

1/24 Spud 12-13-50
 D&A TD 2292
 8" @ 106' Miss Chat 2236-39
 4 1/2" @ 2236 1/2
 TD 2240 DD 2267
 FU 300' wtr DD
 Kinderhook shale 2291-92 TD
 1300' wtr D&A
ABANDONED

