


Section 26 Township 16 Range 5 E

Well No. #2 Peterson

Company Mendenhall Drlg. et al

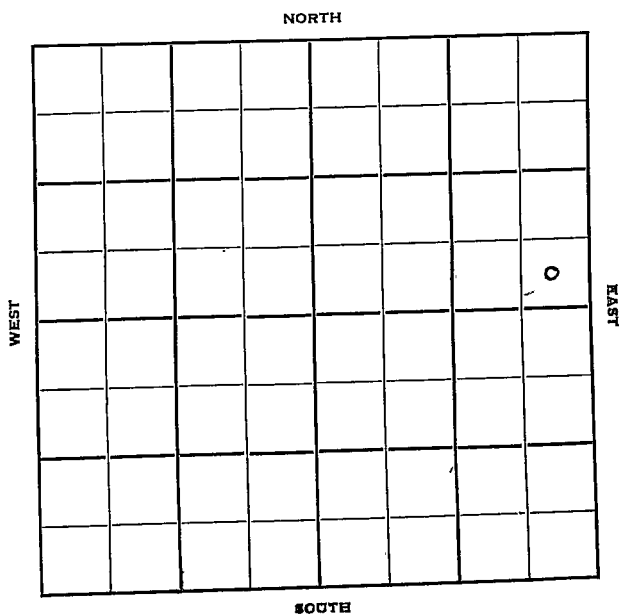

Morris

Sec. 26 Twp. 16 R. 5E

Well No. #2 Peterson Farm

Mendenhall Drlg. et al Company

Contractor

3 Mile Creek Pool

NORTH

Ft. from N. Line


330

Ft. from S. Line

370

Ft. from E. Line

Ft. from W. Line

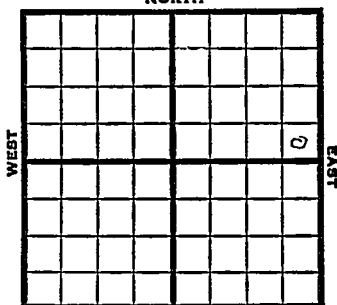

SE SE NE

(Twin Well)

SOUTH

1951

Elev. -

REPORT

10/3

R U R

10/10

D&A TD 2273'

Miss 2208 Kh. 2271-73

DST 2210-73 TD open $1\frac{1}{2}$ hr.

Rec. 450' mud

D&A

ABANDONED

County Morris State Kansas
 Sec. 26 (Blk. 16) (Sur. 5E) Map No. 16
 Operator Mendenhall Drlg. etal.
 Well No. 2 Farm Peterson
 Elev. _____ Location SE SE NE (twin well)

FIRST REPORT									

330 Ft. From S Line NE

370 Ft. From E Line Quarter

1st. Report OCT 3 1951

Completion _____

Remarks _____

Spudding Date _____


Drig. Data _____

3 Mile creek Pool

RUR

J. E. TYRA

County Morris State Kansas
 Sec. 26 (Blk. Twp.) 16 (Sur. Rge.) 5E Map No. _____
 Operator Mendenhall Drlg. etal.
 Well No. 2 Farm Peterson
 Elev. _____ Location SE SE NE (twin well)

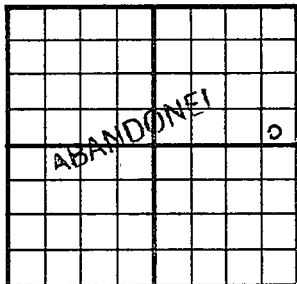

330 Ft. From S Line NE
370 Ft. From E Line Quarter

1st. Report

Completion OCT 10 1951

Remarks 3 Mile Creek Pool

Spudding Date

Drlg. Data D & A TD 2273

Miss. 2208 Kh. 2271-73 DST 2210-73 TD
open 1½ hr. Rec. 450' mud

D & A

J. E. TYRA