

Section 26 Township 16 Range 5E **KANSAS**Well No. #4 PetersonCompany Kaester & Morgan

NORTH

							0

SOUTH

16

EAST

WEST

Morris

KANSAS

Sec. 26 Twp. 16 R. 5E

Well No. #4 Peterson Farm

Kaester & Morgan Company

Slusser Contractor

3 Mi Creek


 Ft. from N. Line

330 Ft. from S. Line

330 Ft. from E. Line

 Ft. from W. Line

SE SE SE

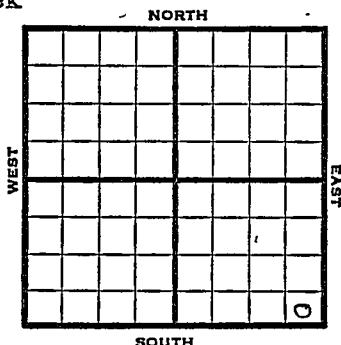

1952

Elev. 1490' REPORT

1/23

Location

2/6

Drlg.

2/13

No report

2/19

Drlg. 560'

3/26

Spud 2-1-52

D&A TD 2306 8" @ 178


Chat 2241 TD 2234 5" @ 2234

Kh. 2304-06 FU 800' wtr.

24 hr. TD 2306

D&A

ABANDONED

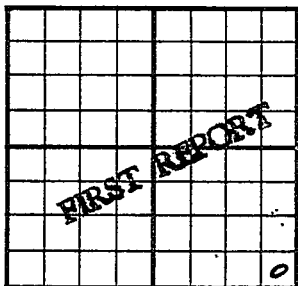County Morris State KansasSec. 26 (Blk. Twp.) 16 (Sur. Rge.) 5E Map No.Operator Kaester & MergenWell No. 4 Farm PetersonElev. Location SE SE SE330 Ft. From S Line SE330 Ft. From E Line Quarter1st. Report JAN 23 1952

Completion


Remarks

Slusser - Contr.

Spudding Date

Drlg. Data 3 Mile CreekLocationJ. E. TYRA

County Morris State Kansas
 Sec. 26 (Blk. 16) (Sur. 5E) Map No. _____
 Operator Koester & Mergen
 Well No. 4 Farm Peterson
 Elev. 1490 Location SE SE SE

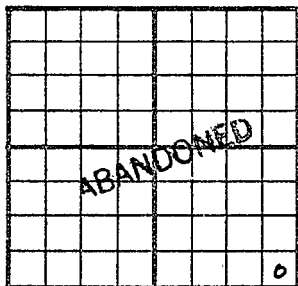

330 Ft. From S Line SE
330 Ft. From E Line Quarter

1st. Report

Completion . MAR 26 1952

Remarks 3 mile creek Pool

Slusser - Contr.

Spudding Date 2-1-52

Drlg. Data D & A TD 2306

8" @ 178 Chat 2241 TD 2234 5" @ 2234

Kh. 2304-06 FU 800' water 24 hr. TD 2306

D & A