


Section 26 Township 16 Range 5 E

Well No. # 1 Wilms

Company Koester & Mergen

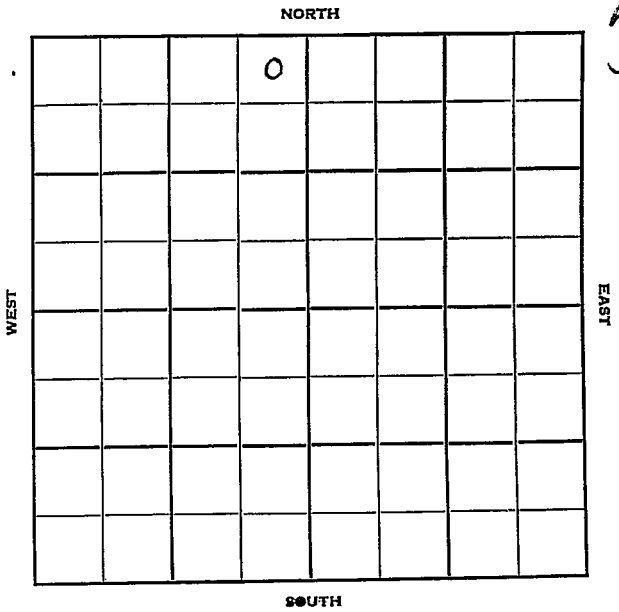

Morris

KANSAS

Sec. 26 Twp. 16 R. 5 E

Well No. # 1 Wilms Farm

Koester & Mergen Company

Slusser Drlg. Contractor

3 Mile Creek Pool


330 Ft. from N. Line

Ft. from S. Line

330 Ft. from E. Line

Ft. from W. Line

NE NE NW

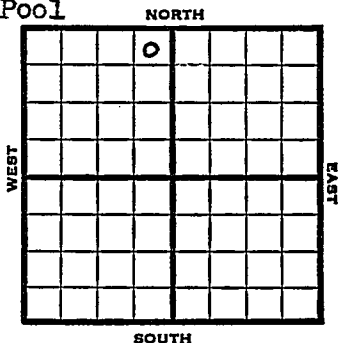

1951 Elev. 1483' REPORT

3/28 Spud 3-25-51  
8" @ 168  
Drlg. 250'

4/11 Spud 3-25-51  
E & A TD 2312'  
8" @ 168'  
Miss 2260'  
5" @ 2261'  
TD 2291' HFW DD 2312' TD water  
D & A

**ABANDONED**

County Morris State Kansas

Sec. 26 (Blk. 16 (Sur. 5E (Twp. Rge.) Map No.

Operator Koester & Mergen

Well No. 1 Farm Wilms

Elev. 1483 Location NE NE NW

		0		

FIRST REPORT

330 Ft. From N Line NW

330 Ft. From E Line Quarter

1st. Report MAR 28 1951

Completion

Remarks

Slusser Drig. - Contr.

Spudding Date 3-25-51

Drig. Data 3 Mile Creek Pool

8" @ 168 drlg. 250

J. E. TYRA

County Morris State Kansas

Sec. 26 (Blk. Twp.) 16 (Sur. Rge.) 5E Map No.

Operator Koester & Mergen

Well No. 1 Farm Wilms

Elev. 1483 Location NE NE NW

			o				

ABANDONED

330 Ft. From N Line NW

330 Ft. From E Line Quarter

Ist. Report

Completion APR 11 1951

Remarks 3 Mile Creek Pool

Slusser Drlg. - Contr.

Spudding Date 3-25-51

Drlg. Data D & A TD 2312

8" @ 168 Miss. 2260 5" @ 2261

TD 2291 HFW DD 2312 TD water

D & A