

Section 26 Township 16 Range 10 E

Well No. # 2 Corwell (Cornwell)

Company ~~Winkler-Koch~~ Woodriver Oil

NORTH

							0

WEST

EAST

SOUTH

Lyon

KANSAS

Sec. 26 Twp. 16 R. 10E

Well No. #2 Cornwell Farm

Woodriver Oil
~~Winkler-Koch~~

Company

Contractor

Bushong Pool


990 Ft. from N. Line

Ft. from S. Line

330 Ft. from E. Line

Ft. from W. Line

SE NE NE

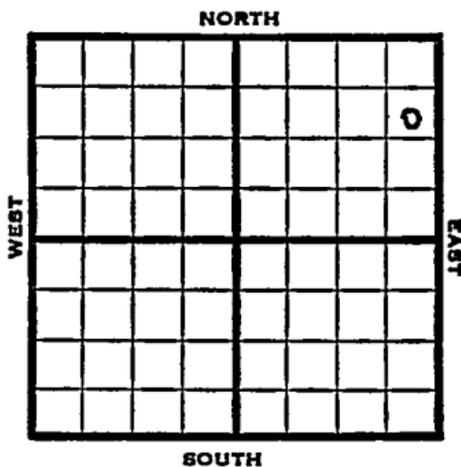

1953

Elev. -

REPORT

8/5

Location

9/2

Spud 8-3-53

SWD Well

TD 3255

8" @ 217

Top 825, KC 1454, Miss 2471,

DST 2475-93, opn 1/2 hrs., rec. 3' mud
415#

Kh 2833, Hunton 2970

DST 2971-78, opn 1 hrs., rec. 35'

oil, 30' mud & wtr., 390#

Viola 3066

DST 3068-80, opn 1/2 hrs., rec. 1730'

sw, 1050#

Simp. 3120

DST 3159-66, opn 1/2 hrs., rec. 5' mud
925#

St. Peter sd. 3169

DST 3162-75, opn 1 hr., rec. 35' vsoc
945#

Arb. 3222

TD 3255

PB 2925, PB 1185

5" @ 847

Comp. for SWD WELL

ABANDONED

Kansas

Map No. _____ Sec. 26 Twp. 16 R. 10EWell No. 2 Cornwell

Woodriver Oil

Company

CORRECTION

Contractor

SE NE NE

SECTION PLAT

990 Ft. from N. Line

_____ Ft. from S. Line

330 Ft. from E. Line

_____ Ft. from W. Line

			0

Lyon County

Location _____

Rig up _____

Drilling and Remarks:

Reported
Winkler-Koch

RECORD

Cased _____ in., _____ ft.

Sand _____

Gas _____

Oil _____

Total Depth _____

PRODUCTION

1st 24 hrs. Nat. _____

1st 24 hrs. after shot _____

Gas _____ Cu. Ft.

Dry Hole _____

Abandoned _____

Date

AUG 12 1953 19

J. G. MCGEHEE

Scout

County Lyon State Kansas

Sec. 26 (Blk. Twp.) 16 (Sur. Rge.) 10E Map No.

Operator Winkler-Koch

Well No. 2 Farm Cornwell

Elev. _____ Location SE NE NE

							0

990 Ft. From N Line NE

330 Ft. From E Line Quarter

Ist. Report 416 5 1953

Completion _____

Remarks _____

Spudding Date _____

Drlg. Data Bushong Pool

Location _____

J. G. McGEHEE

