

Lyon

KANSAS



Section 26 Township 16 Range 10E

Well No. #1 Cornwell

Company Stanolind & Winkler-Koch

NORTH

							0

WEST

EAST

SOUTH

Lyon  
16

KANSAS

R. 10E ✓

Sec. 26

Twp.

R.

Well No. #1 Cornwell Farm

Stanolind & Winkler-Koch Company

Wakefield Contractor


Wildcat  
330' Ft. from N. Line

Ft. from S. Line

330' Ft. from E. Line

Ft. from W. Line

NE NE NE

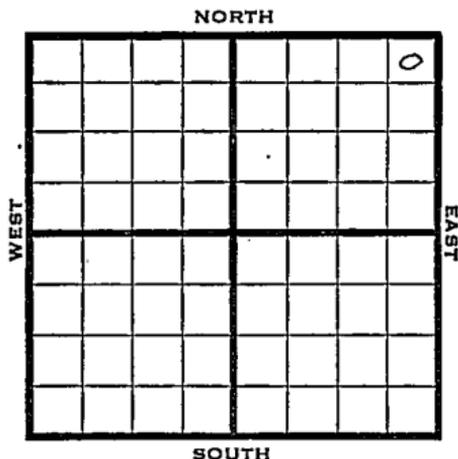

1950

REPORT

3/22

RUR

4/26

TD 2967'

8" @ 208'

Lans. 1440'

KC 1583'

BKC 1815'

Cherokee 2057'

Miss 2471'

Por 2483-84'

2491-92'

Stain 2497-2503

DST 2480-2511

Rec 36' mud N/S

Hunton 2950

DST 2952-67 TD

Rec 1000' oil

Gr 29

5" @ 2952

Swb 20 bbls fluid / 10% wtr. ph

Comp 257 BOPD / 64 BWPD

Comp

2950  
2471  
479

**COMPLETED**

Map No. \_\_\_\_\_ Sec. 26 Twp. 16 R. 10E

Well No. 1 Cornwell

Stanolind, Winkler-Koch Company

Contractor

NE NE NE


E/1345  
SECTION PLAT

330 Ft. from N. Line

\_\_\_\_\_ Ft. from S. Line

330 Ft. from E. Line

\_\_\_\_\_ Ft. from W. Line

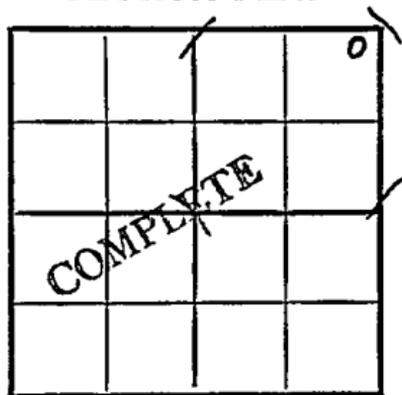

Lyon County

Location \_\_\_\_\_

Rig up \_\_\_\_\_

Drilling and Remarks:

8" C 208  
 Lams. 1440  
 KC. 1583  
 BK.C. 1815  
 Cherokee 2057  
 Miss. 2471  
 Per. 2483-84  
 2491-92

Date

## RECORD

Cased \_\_\_\_\_ in., \_\_\_\_\_ ft.

Sand \_\_\_\_\_

Gas \_\_\_\_\_

Oil \_\_\_\_\_

Total Depth 2967

## PRODUCTION

1st 24 hrs. Nat. \_\_\_\_\_

1st 24 hrs. after shot \_\_\_\_\_

Gas \_\_\_\_\_ Cu. Ft.

Dry Hole \_\_\_\_\_

Abandoned \_\_\_\_\_


APR 26 1950 19

J. E. TYRA Scout

11, n 7



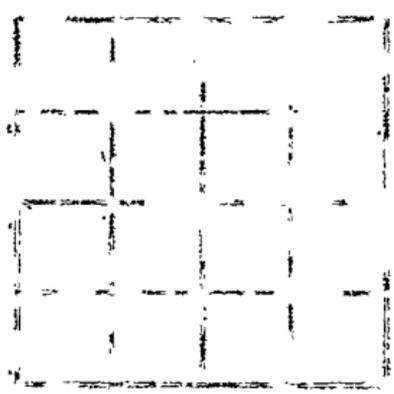





500 2952  
 Rec. 100  
 DST 2952  
 Norton 2950  
 Rec. 36  
 DST 2480-2511  
 Starn 2497-2503

Map No. \_\_\_\_\_ Sec. 26 Twp. 16 R. 10E

Well No. 1 Cornwell

Stanolind &amp; Winkler-Koch Company

Wakefield Contractor

NE NE NE

330 Ft. from N. Line

\_\_\_\_\_ Ft. from S. Line

330 Ft. from E. Line

\_\_\_\_\_ Ft. from W. Line

Lyon County

## SECTION PLAT



Location \_\_\_\_\_

Rig up \_\_\_\_\_

Drilling and Remarks:

R U R

## RECORD

Cased \_\_\_\_\_ in., \_\_\_\_\_ ft.

Sand \_\_\_\_\_

Gas \_\_\_\_\_

Oil \_\_\_\_\_

Total Depth \_\_\_\_\_

## PRODUCTION

1st 24 hrs. Nat. \_\_\_\_\_

1st 24 hrs. after shot \_\_\_\_\_

Gas \_\_\_\_\_ Cu. Ft.

Dry Hole \_\_\_\_\_

Abandoned \_\_\_\_\_

Date

MAR 22 1950

19

J. E. TYRA Scout

MAR 24 1950

Scout Cards .....

Land Small Map .....

Land Wall M. 3 .....

Tracings .....

France Map .....

Pierce Map .....

Misc. ....