


Morris

KANSAS

SECTION 26 TOWNSHIP 16 RANGE 8E

WELL NO. #1 Droll

COMPANY E.H. Adair, etal

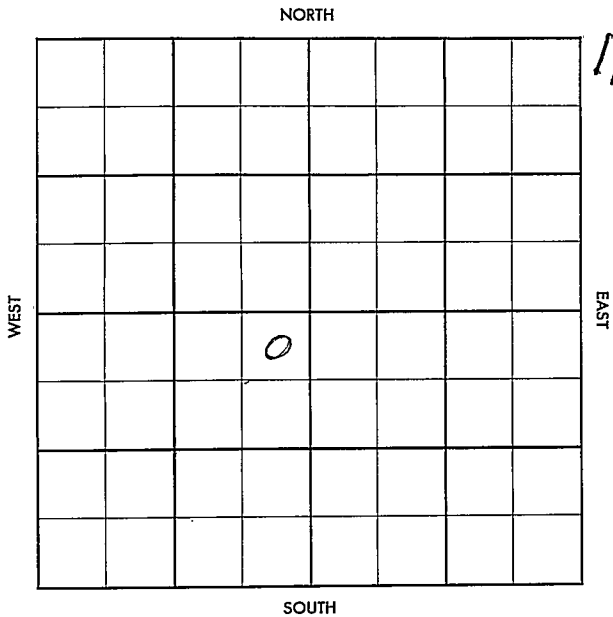

WILDCAT

No County Map

FORM 513 SUNRAY

County Morris Elev. 1363 RB
 Sec. 26 Twp. 16 Rge. 8E
 Company E. H. Adair et al.
 Farm Name Droll No. 1

TOPS	DEPTH	LOG	DATUM
Anh.			
Tp.			
H.			
Tr.			
Dg.			
Bl. <u>Kh.</u>	<u>2731</u>		
L. <u>H7.</u>	<u>2880</u>		
K.C.			
B.K.C.			
Ce.			
C.			
M.			
M.			
K.			
Mz.			
Ma.			
V.	<u>3026</u>		
S.			
S.			
A.			
R.			
Pe.			
G.			
T.D.	<u>3119</u>		

Loc. in Sec. NE NE SW
 Geol. _____
 Contr. Rex & Morris

Pool Wildcat

DST REPORT			
JAN 3 '57			

Date Comm. 12-22-56
8" @ 116/125 DST 2880-2909 open 1 hr.
rec. 2295' wtr. DST 3026-311

Co. Sec. No. Sec. T. R.

938
1363
-575

FORM 513 SUNRAY

No County Map

County Morris Elev. 1363 RB
 Sec. 26 Twp. 16 Rge. 8E
 Company V. F. Adair et al.
 Farm Name Droll No. 1

TOPS	DEPTH	LOG	DATUM	Loc. in Sec.
Anh. <u>Lsg</u>	<u>1568</u>			NE NW SW
Tp. <u>Bick</u>	<u>1938</u>			
H. <u>MISS</u>	<u>2496</u>			
Tr.				
Dg.				
Bl. <u>Kh.</u>	<u>2731</u>			
L. <u>in.</u>	<u>2880</u>			
K.C.				Geol.
B.K.C.				Contr.
Ce.				<u>Rex & Morris</u>
C.				Pool
M.				<u>Willcat</u>
M.				<div style="border: 1px dashed black; padding: 5px; text-align: center;"> <p>ABANDONED</p> <p>JAN 9 '57</p> </div>
K.				
Mz.				
Mo.	<u>2958</u>			
V.	<u>3026</u>			
S. <u>sd</u>	<u>3143</u>			
S. <u>s</u>				
A.				
R.				
PE.				
G.				
T.D.	<u>3119</u>			

Date Comm. 12-22-56

8" @ 116/125 DST ~~2850-2880~~ open 1 hr.

rec. 2885' DST 3020-3119

105' MW BHP

1040/20 DST 5' PKI 2880

-2989 30" rec 2275 SW FT

760-1020 BHP 1040/20"

D & A