


Section 27 Township 16 Range 4E

Well No. 1 Gehrke

Company Oil Well Drlg.

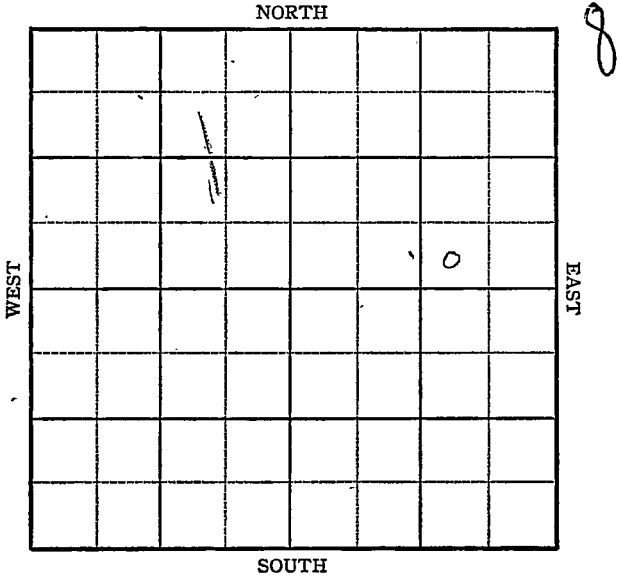

Sec. 27 Twp. 16 R. 4-E

Well No. #1 Gehrke Farm


Oil Well Drlg. Company

         Ft. from N. Line

330 Ft. from S. Line

990 Ft. from E. Line

         Ft. from W. Line

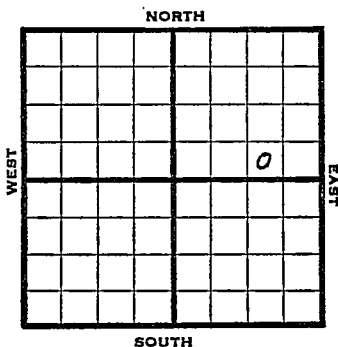

SW SE NE

1945 Elev. 1425' REPORT

9/26 Derrick

10/3 "

10/10 "

10/17 "

10/24 "

10/31 "

11/7 "

11/14 "

11/21 8" @ 72

Drlg. 335

11/28 Drlg. 1250

12/5 Drlg. 1695

12/12 Miss. 2291

TD 2298

5" @ 2290 RUST

12/20 " "

12/29 Shut down.

1946

1/10 Drlg. 2297'

1/17 Drlg. 2360'

1/23 Miss. 2291

5" @ 2290

TD 2386'

ABANDONED

**KANSAS**  
Kansas

Pool Name Lost Spring North

Map No. 26 Sec. 27 Twp. 16 R. 4E

Well No. 1 Gehrke

Oil well Drlg. Company \_\_\_\_\_

**FIRST REPORT**

Contractor \_\_\_\_\_

SW SE NE


**SECTION PLAT**

\_\_\_\_\_ Ft. from N. Line

330 Ft. from S. Line

990 Ft. from E. Line

\_\_\_\_\_ Ft. from W. Line

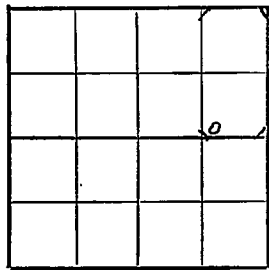

Dickinson County

Location \_\_\_\_\_

Rig up \_\_\_\_\_

Drilling and Remarks:  
derrick

**RECORD**

Cased \_\_\_\_\_ in., \_\_\_\_\_ ft.

Sand \_\_\_\_\_

Gas \_\_\_\_\_

Oil \_\_\_\_\_

Total Depth \_\_\_\_\_

**PRODUCTION**

1st 24 hrs. Nat. \_\_\_\_\_

1st 24 hrs. after shot \_\_\_\_\_

Gas \_\_\_\_\_ Cu. Ft.

Dry Hole \_\_\_\_\_

Abandoned \_\_\_\_\_

Date

SEP 26 1945 19

S. J. LEWIS Scout

KANSAS Kansas Pool Name Lost Spring NorthMap No. 26 Sec. 27 Twp. 16 R. 4EWell No. 1 Gehrke

Oil Well Drlg. \_\_\_\_\_ Company \_\_\_\_\_

ABANDONED

Contractor \_\_\_\_\_

SW SE NE

E11425  
SECTION PLAT

\_\_\_\_\_ Ft. from N. Line

330 Ft. from S. Line990 Ft. from E. Line

\_\_\_\_\_ Ft. from W. Line

			0

Dickinson

Location \_\_\_\_\_

Rig up \_\_\_\_\_

Drilling and Remarks:

Miss 2291  
5" @ 2296

## RECORD

Cased \_\_\_\_\_ in., \_\_\_\_\_ ft.

Sand \_\_\_\_\_

Gas \_\_\_\_\_

Oil \_\_\_\_\_

Total Depth 2386

## PRODUCTION

1st 24 hrs. Nat. \_\_\_\_\_

1st 24 hrs. after shot \_\_\_\_\_

Gas \_\_\_\_\_ Cu. Ft.

Dry Hole \_\_\_\_\_

Abandoned \_\_\_\_\_

Date

JAN 23 1946 19S. J. LEWIS Scout