

KANSAS

Section 27 Township 16 Range 4E

Well No. 2 Scully

Company Slusser Drlg.

Lost Spring
NORTH

15

WEST

EAST

0

SOUTH

Sec. 27 Twp. 16 R. 4E

Well No. #2 Scully Farm

Slusser Drlg. Company

Lost Spring Pool (Slusser Drlg., Cont.)


Ft. from N. Line

330' Ft. from S. Line

Ft. from E. Line

990' Ft. from W. Line

SE SW SE

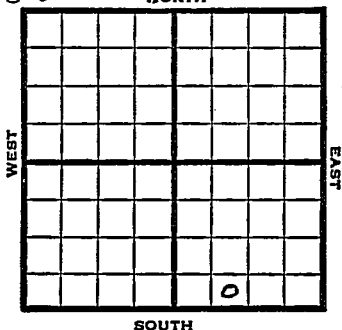

1949 Elev 1372' REPORT

7/20 8" @ 90'
Drlg. 870'

7/27 Miss 2244-45'
TD 2245'
5" @ 2245'

8/3 TD 2270'
20 qts 2255-65
CO

8/10 TD 2270'
Miss 2244'
5 @ 2245'
5" @ 2245'
20 qts.
1000 acid
Pump 25 oil Pot
36.0 Gr.
Comp

COMPLETED

Map No. _____ Sec. 27 Twp. 16 R. 4E

Well No. 2 Scully

Slusser Drlg. _____ Company

Slusser Drlg. _____ Contractor

SE SW SE

FIRST REPORT
SECTION PLAT

_____ Ft. from N. Line

330 Ft. from S. Line

_____ Ft. from E. Line

990 Ft. from W. Line

Dickinson County

Location _____

Rig up _____

Drilling and Remarks:

8" @ 90
870

RECORD

Cased _____ in., _____ ft.

Sand _____

Gas _____

Oil _____

Total Depth _____

PRODUCTION

1st 24 hrs. Nat. _____

1st 24 hrs. after shot _____

Gas _____ Cu. Ft.

Dry Hole _____

Abandoned _____

Date

JUL 20 1949 19

S. J. LEWIS

Scout

Map No. K 26 Sec. 27 Twp. 16 R. 4E

Well No. 2 Scully

Slusser Drlg. Company

COMPLETE

Contractor

SE SW SE

E 11372

SECTION PLAT

Ft. from N. Line

330 Ft. from S. Line

Ft. from E. Line

990 Ft. from W. Line

Dickinson County

Location _____

Rig up _____

Drilling and Remarks:

Misc 2244
5" @ 2245
2095, 1000000
Pump 25 oil Pt
36 6/11

RECORD

Cased _____ in., _____ ft.

Sand _____

Gas _____

Oil _____

Total Depth 2270

PRODUCTION

1st 24 hrs. Nat. _____

1st 24 hrs. after shot _____

Gas _____ Cu. Ft.

Dry Hole _____

Abandoned _____

Date

AUG 10 1949 19

S. J. LEWIS Scout