


Section 27 Township 16 Range 4E

Well No. #3 Scully

Company Slusser

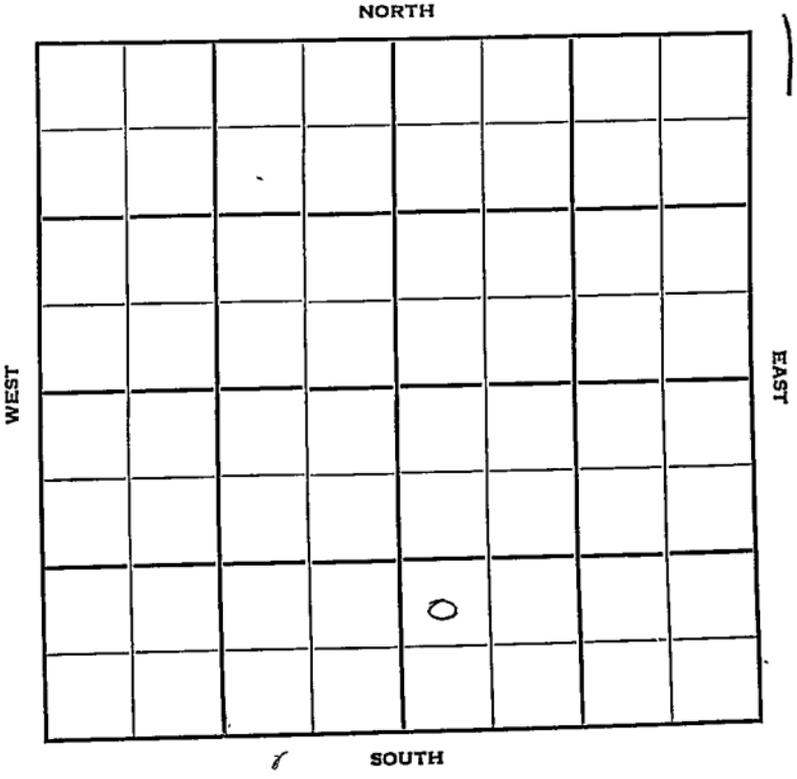

Sec. 27 Twp. 16 R. 4E

Well No. #3 Scully Farm

Slusser Company

Lost Spring Contractor


 Ft. from N. Line

990' Ft. from S. Line

 Ft. from E. Line

330' Ft. from W. Line

NW SW SE

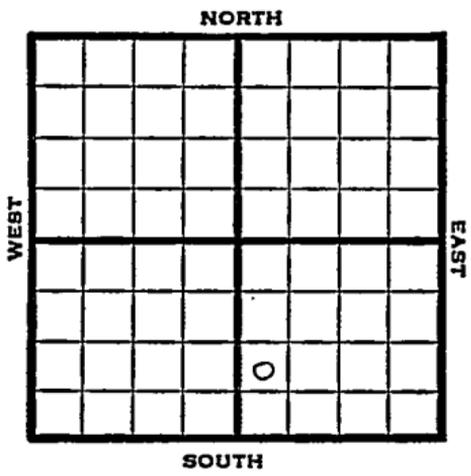

1950 Elev 1368' REPORT

1/25 MIM

2/22 TD 2272'
8"@ 100
5"@ 2233'
Miss 2231'
25 BOPD
Comp

COMPLETED

Map No. _____ Sec. 27 Twp. 16 R. 4E


Well No. 3 Scully

Slusser Company

Contractor

NW SW SE

SECTION PLAT

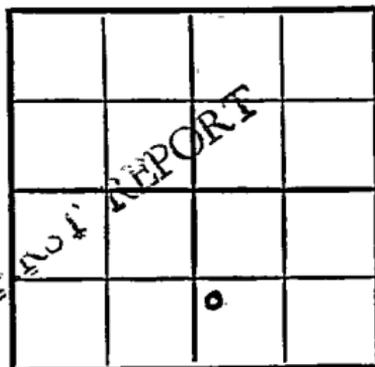

_____ Ft. from N. Line

990 Ft. from S. Line

_____ Ft. from E. Line

330 Ft. from W. Line

Dickinson County

RECORD

Location _____

Rig up _____

Drilling and Remarks:

M I M

Cased _____ in., _____ ft.

Sand _____

Gas _____

Oil _____

Total Depth _____

PRODUCTION

1st 24 hrs. Nat. _____

1st 24 hrs. after shot _____

Gas _____ Cu. Ft.

Dry Hole _____

Abandoned _____

Date

JAN 22 5 1950

E. TYRA

Scout

Map No. _____ Sec. 27 Twp. 16 R. 4E

Well No. 3 Scully

Slusser Company

Contractor

NW SW SE

E. 1368
SECTION PLAT

_____ Ft. from N. Line

990 Ft. from S. Line

_____ Ft. from E. Line

330 Ft. from W. Line

		COMPLETE	

Dickinson County

Location _____

Rig up _____

Drilling and Remarks:

*8" @ 100
5" @ 2233
Miss 2231
25 B.O.P.D*

RECORD

Cased _____ in., _____ ft.

Sand _____

Gas _____

Oil _____

Total Depth 2272

PRODUCTION

1st 24 hrs. Nat. _____

1st 24 hrs. after shot _____

Gas _____ Cu. Ft.

Dry Hole _____

Abandoned _____

Date

FEB 22 1950

J. E. TYRA

19

Scout