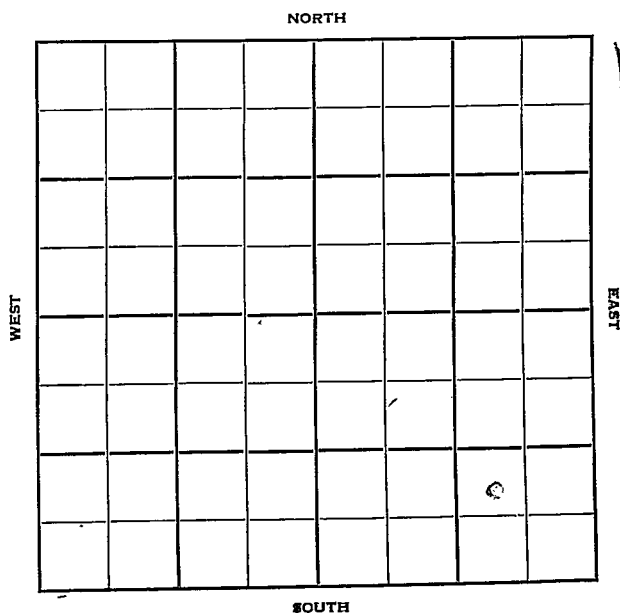


KANSAS

Section 27 Township 16 Range 4-EWell No. #5 SullyCompany Slusser Drlg

Dickinson

KANSAS

Sec. 27 Twp. 16 R. 4E

Well No. #5 Scully Farm

Slusser Drlg. Company

Contractor

Lost Springs


 Ft. from N. Line

990' Ft. from S. Line

 Ft. from E. Line

990' Ft. from W. Line

NE SW SE

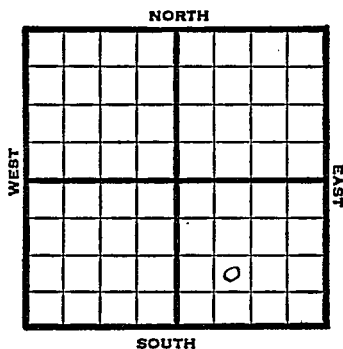

1950

REPORT

4/5 8-5/8" @ 98'
Drlg. 1445'

4/19 TD 2285'
8 5/8" @ 98'
Miss 2250'
5"@ 2250
TD 2285'
60 qts 2260-85
250' oil in hole
Comp 25 bopd
Comp


COMPLETED

Map No. _____ Sec. 27 Twp. 16 R. 4EWell No. 5 Scully_____Slusser Drlg._____
Company_____
Contractor

NE SW SE

_____Ft. from N. Line990 Ft. from S. Line_____Ft. from E. Line990 Ft. from W. Line

SECTION PLAT

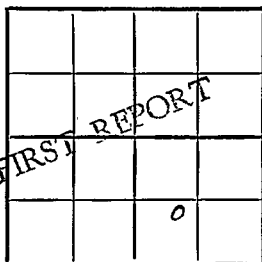Dickinson County

Location _____

Rig up _____

Drilling and Remarks:

8 5/8" @ 98drllr. 1445

RECORD

Cased _____ in., _____ ft.

Sand _____

Gas _____

Oil _____

Total Depth _____

PRODUCTION

1st 24 hrs. Nat. _____

1st 24 hrs. after shot _____

Gas _____ Cu. Ft.

Dry Hole _____

Abandoned _____

Date

APR 5 1950 19J. E. TYRA

Scout

Map No. _____ Sec. 27 Twp. 16 R. 4EWell No. 5 Scully

_____ Slusser Drlg. _____ Company

_____ Contractor


NE SW SE

SECTION PLAT

_____ Ft. from N. Line

990 Ft. from S. Line

_____ Ft. from E. Line

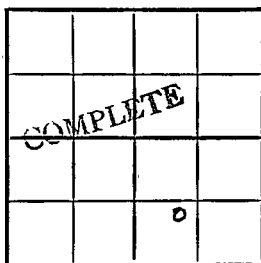990 Ft. from W. Line

Dickinson County

Location _____

Rig up _____

Drilling and Remarks:

8 7/8" C 98Min. 22505" C 2250T.D. 228560 gts. 2260-85250' oil in HoleComp. 25 bpd

Date

RECORD

Cased _____ in., _____ ft.

Sand _____

Gas _____

Oil _____

Total Depth 2285

PRODUCTION:

1st 24 hrs. Nat. _____

1st 24 hrs. after shot _____

Gas _____ Cu. Ft.:

Dry Hole _____

Abandoned _____

APR 19 1950 19

J. E. TYRA

Scout