


Section 27 Township 16 Range 4E

Well No. #7 Sully

Company Slusser Drlg.

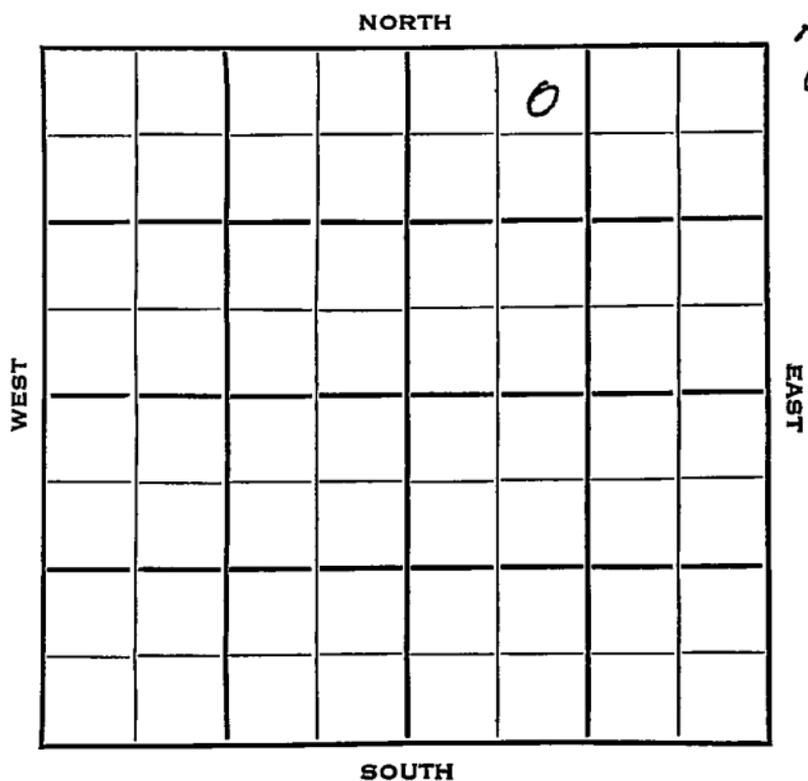

Sec. 27 Twp. 16 R. 1E

Well No. #7 Sully Farm

Slusser Drlg. Company

Contractor


330 Ft. from N. Line

Ft. from S. Line

Ft. from E. Line

990 Ft. from W. Line

NE NW NE

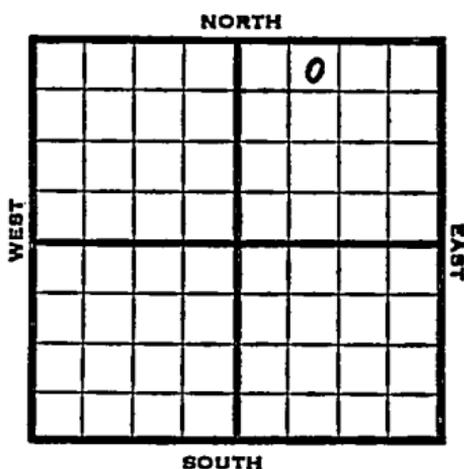

1953 Elev. 1398' REPORT

7/29 Spud 7-25-53
8" @ 90
Drlg.

9/9 Spud 7-25-53
D&A
TD 2330
8" @ 90
Miss 2261
TD 2267
5" @ 2267
DD 2330
D&A

ABANDONED

County Dickinson State Kansas

Sec. 27 (Blk. Twp.) 16 (Sur. Rge.) 4E Map No.

Operator Slusser Drlg.

Well No. 7 Farm Sully

Elev. _____ Location NE NW NE

				0	

330 Ft. From N Line NE

990 Ft. From W Line Quarter

1st. Report JUL 29 1953

Completion _____

Remarks _____

Spudding Date 7-25-58

Drig. Data

8" @ 90 drlg.

