

Section 28 Township 16 Range 4E

Well No. #3 Biehler

Company H. J. Uhl

Lost Spring Pool ^{NORTH}

							o

16

WEST

EAST

SOUTH

KANSAS

Sec. 28 Twp. 16 R. 4-E

Well No. 3 Biehler Farm

H. J. Uhl Company

Lost Spring


Ft. from N. Line

990' Ft. from S. Line

330' Ft. from E. Line

Ft. from W. Line

NE SE SE

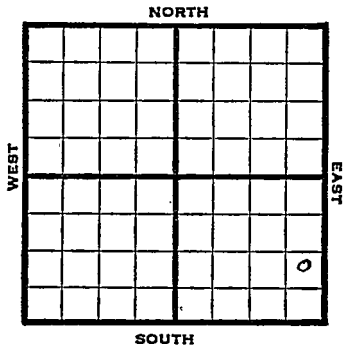

1947 Elev. 1381' REPORT

10/29 10" @ 109'
Drlg. 220'

11/5 Drlg. 2053'

11/12 Mississippi 2318'
Total Depth 2352'

ABANDONED

Kansas

Map No. _____ Sec. 28 Twp. 16 R. 4E

Well No. 3 Biehler

H. J. Uhl _____ Company

FIRST REPORT _____ Contractor

NE SE SE

SECTION PLAT

_____ Ft. from N. Line

990 Ft. from S. Line

330 Ft. from E. Line

_____ Ft. from W. Line

			o

Dickinson County

Location _____

Rig up _____

Drilling and Remarks:

10" @ 109

— drlg. 220

RECORD

Cased _____ in., _____ ft.

Sand _____

Gas _____

Oil _____

Total Depth _____

PRODUCTION

1st 24 hrs. Nat. _____

1st 24 hrs. after shot _____

Gas _____ Cu. Ft.

Dry Hole _____

Abandoned _____

Date

OCT 29 1947 19

S. J. LEWIS

Scout

