

KANSAS


Dickinson

FORM 51 IOM 12-16-PETROL

Section 28 Township 16 Range 4E

Well No. 2 Biehler

Company H. Uhl et al

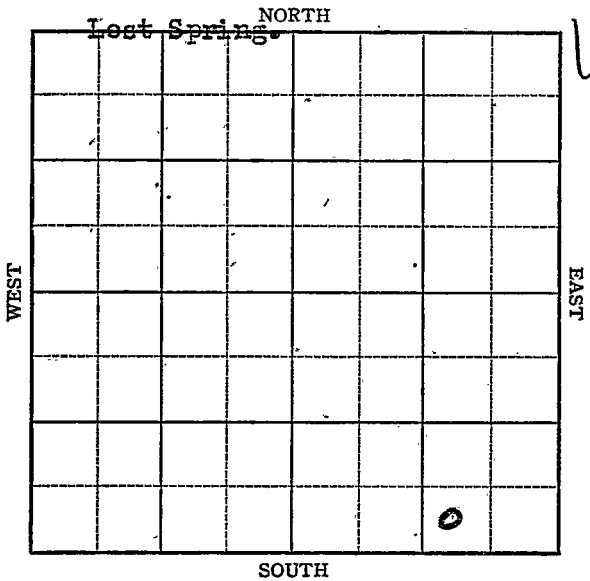




Sec. 28 Twp. 16 R. 4-E

Well No. 2 Biehler Farm  
H. Uhl etal Company

Lost Spring  
Ft. from N. Line  
330 Ft. from S. Line  
990 Ft. from E. Line  
Ft. from W. Line

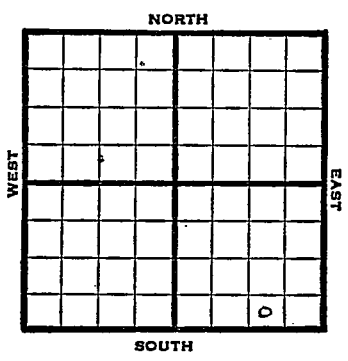

SW SE SE

1947 Elev 1354' REPORT

7/30 120 run csg..

8/6 8" @ 120'  
Drlg 1920'

8/13 Miss. 2286'  
T.D. 2326'  
Abandoned

ABANDONED

Map No. \_\_\_\_\_ Sec. 28 Twp. 16 R. 4E

Well No. 2 Biehler

H. Uhl etal. \_\_\_\_\_ Company

FIRST REPORT \_\_\_\_\_ Contractor

SW SE SE

SECTION PLAT

\_\_\_\_\_ Ft. from N. Line

330 Ft. from S. Line

990 Ft. from E. Line

\_\_\_\_\_ Ft. from W. Line


Dickinson County

Location \_\_\_\_\_

Rig up \_\_\_\_\_

Drilling and Remarks:

120 run csg

RECORD

Cased \_\_\_\_\_ in., \_\_\_\_\_ ft.

Sand \_\_\_\_\_

Gas \_\_\_\_\_

Oil \_\_\_\_\_

Total Depth \_\_\_\_\_

PRODUCTION

1st 24 hrs. Nat. \_\_\_\_\_

1st 24 hrs. after shot \_\_\_\_\_

Gas \_\_\_\_\_ Cu. Ft.

Dry Hole \_\_\_\_\_

Abandoned \_\_\_\_\_

Date

JUL 30 1947 19

S. J. LEWIS Scout

