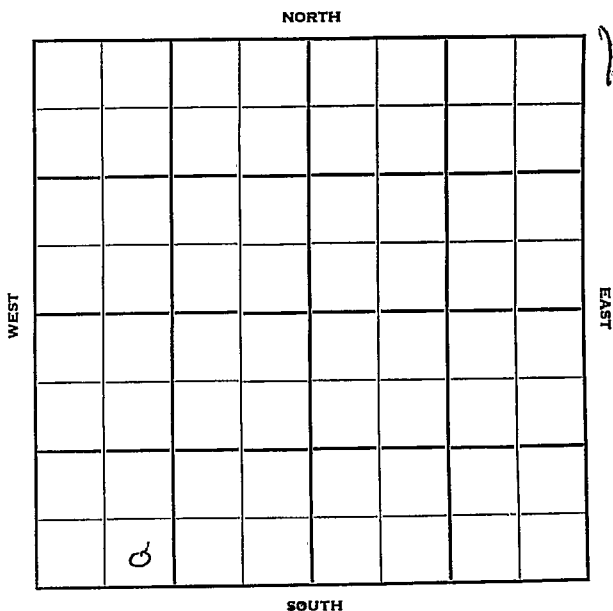


Section 28 Township 16 Range 4EWell No. #1 WillsCompany Irwin Daetwiler et al

Dickinson

KANSAS

Sec. 28 Twp. 16 R. 4 E ✓

Well No. # 1 Wills Farm

Irwin Daetwiler et al Company

Slusher Contractor


 Ft. from N. Line

330 Ft. from S. Line

 Ft. from E. Line

990 Ft. from W. Line

SE SW SW

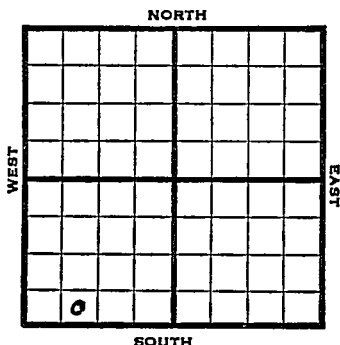

1952


Elev. -

REPORT

5/21 Surf set WOR

6/4 ID 2330' D&A

ABANDONED

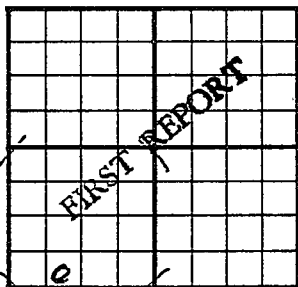County Dickinson State KansasSec. 28 (Blk. 16 (Sur. 43 (Twp. 43 Map No.Operator Irwin Daetwiler et al.Well No. 1 Farm WillsElev. Location SE SW SW330 Ft. From S Line SW990 Ft. From W Line Quarter1st. Report MAY 21 1952

Completion

Remarks


Slusher - Contr.

Spudding Date

Drlg. Data

Surf set WOR

J. G. McGEHEE

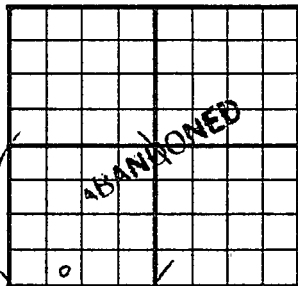County Dickinson State KansasSec. 28 (Blk.) 16 (Sur.) 4E Map No.Operator Irwin Daetwiler et al.Well No. 1 Farm WillsElev. Location SE SW SW

330 Ft. From S Line SW

990 Ft. From W Line Quarter

1st. Report

Completion JUN 4 1952

Remarks

Slusser Drlg. - Contr.

Spudding Date

Drlg. Data

TD 2330 D & A

J. G. McGEHEE