


Section 29 Township 16 Range 4-E

Well No. #1 Riffel

Company C R A Etal
Lost Spring Pool

NORTH

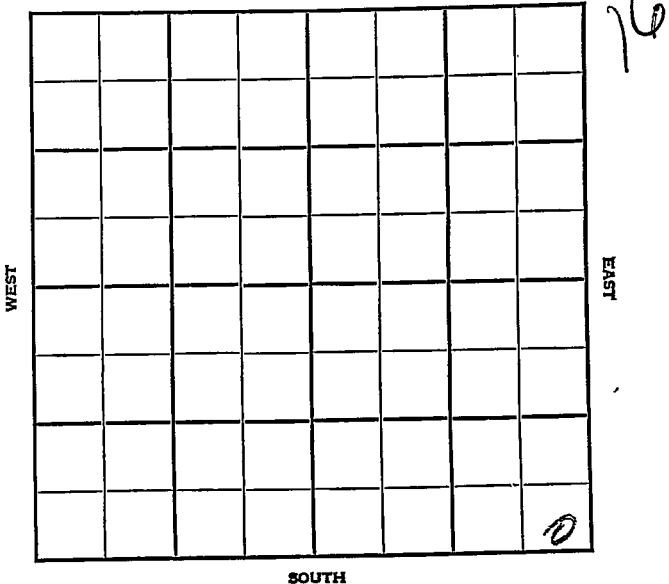

KANSAS

Dickinson ✓

Sec. 29 Twp. 16 R. 4E

Well No. #1 Riffel Farm

C R A et al. Company

Lost Spring Pool


_____ Ft. from N. Line

330' Ft. from S. Line

330' Ft. from E. Line

_____ Ft. from W. Line

SE/C

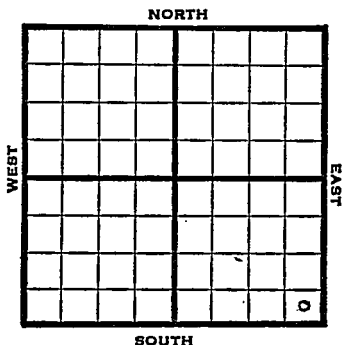

1948

Eli 1414'

REPORT

6/30

RUR

7/14

TD 2402'

Lansing 1808

Miss 2379'

Abandoned

ABANDONED

Map No. _____ Sec. 29 Twp. 16 R. 4E

Well No. 1 Riffel

C R A etal. Company

FIRST REPORT Contractor

SE/C

SECTION PLAT

_____ Ft. from N. Line

330 Ft. from S. Line

330 Ft. from E. Line

_____ Ft. from W. Line

Dickinson County

Location _____

Rig up _____

Drilling and Remarks:

R U R

RECORD

Cased _____ in., _____ ft.

Sand _____

Gas _____

Oil _____

Total Depth _____

PRODUCTION

1st 24 hrs. Nat. _____

1st 24 hrs. after shot _____

Gas _____ Cu. Ft.

Dry Hole _____

Abandoned _____

Date

3 0 1948 19

S. J. LEWIS Scout

Map No. 26 Sec. 29 Twp. 16 R. 4E

Well No. 1 Riffel

C R A etal. Company

ABANDONED

Contractor

SE/C

E. 1414
SECTION PLAT

 Ft. from N. Line

330 Ft. from S. Line

330 Ft. from E. Line

 Ft. from W. Line

Dickinson County

Location

Rig up

Drilling and Remarks:

Loss 1808

Miss 2379

RECORD

Cased in., ft.

Sand

Gas

Oil

Total Depth 2402

PRODUCTION

1st 24 hrs. Nat.

1st 24 hrs. after shot

Gas Cu. Ft.

Dry Hole

Abandoned

Date

JUL 14 1948 19

S. J. LEWIS Scout