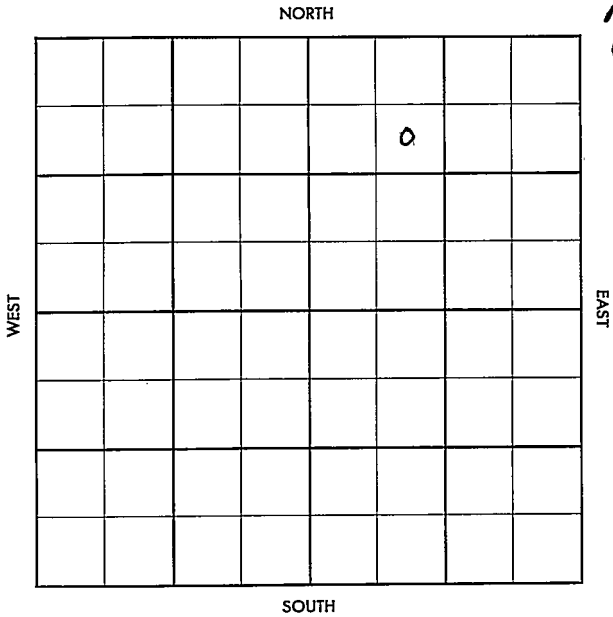


SECTION 29 TOWNSHIP 16 RANGE 4 EWELL NO. #2 Souly "E"COMPANY Anderson-Prichard

Dickinson

KANSAS

SEC.	TWP.	R.
29	16	4E

WELL NO.

#2 Scully "E"

FARM

COMPANY

Anderson Prichard

CONTRACTOR

Glenn Peel

NW Lost Springs


Ft. from N. Line

Ft. from S. Line

Ft. from E. Line

Ft. from W. Line

SE NW NE

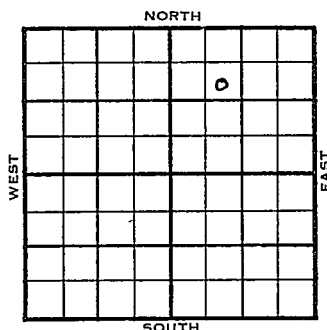

	ELEVATION	REPORT
1955	1409'	
10/19	Comm 10-15-55 8" @ 94/100 Drlg 200	
11/9	Comm 10-15-55 8" @ 94/100 5" @ 2309/140 M 2301 TD 2316 CO to 2316 B/1½ bfph 3 hr 30% wtr DD 2319 S/1 3/4 bfph 30% wtr 5 hr S/9 3/4 bo 8 1/4 bw 6 hr DD 2321 S/7 bfph 6% wtr 4 hr Comp 45 bopd 33 bw	

COMPLETED

Ne County

County **Dickinson** Elev. **1409**
 Sec. **29** Twp. **16** Rge. **4E**
 Company **Anderson-Prichard**
 Farm Name **Scully "E"** No. **2**

TOPS	DEPTH	LOG	DATUM	Loc. in Sec.
Anh.				SE NW NE
Tr.				
H.				
Tr.				
Dg.				
Bl.				
L.				Geol.
K.C.				Contr.
B.K.C.				Glenn Peel
Ce.				
C.				Pool
M.				NW Lost Springs
M.				
K.				
Mz.				
Ma.				
V.				
S.				
S.				
A.				
R.				
Pe.				
G.				
T.D.				

Date Comm. **10-15-55**
8% @ 94/100 drlg. 200

FIRST REPORT

County Dickinson Elev. 1409
 Sec. 29 Twp. 16 Rge. 4E
 Company Anderson-Prichard
 Farm Name Scully "E" No. 2

TOPS	DEPTH	LOG	DATUM	Loc. in Sec.
Anh.				SE NW NE
TP.				
H.				
Tr.				
Dg.				
BL.				
L.				Geol.
K.C.				Contr.
B.K.C.				Glenn Peel
Ce.				Pool
C.				NW Lost Spring
M.	2301		892	
M.				
K.				
Mz.				
Mq.				
V.				
S.				
S.				
A.				
R.				
PE.				COMPLETE
G.				
T.D.	2316			

Date Comm. 10-15-55 NOV 9 1955
8" @ 94/100 5 1/2" @ 2309/140 CO to 2316

B/ 1 1/2 bfph 3 hr. 30% wtr. DD 2319

S/ 1 3/4 bfph 30% wtr. 5 hr.

S/ 9 3/4 bo 8 1/4 bw 6 hr. DD 2321

S/ 7 bfph 6% wtr. 4 hr.

Domp. 45 bopd 33 bw