


Dickinson

KANSAS

SECTION 29 TOWNSHIP 16 RANGE 4E

WELL NO. #1 H. Røffel

COMPANY Augusta Oil Co.

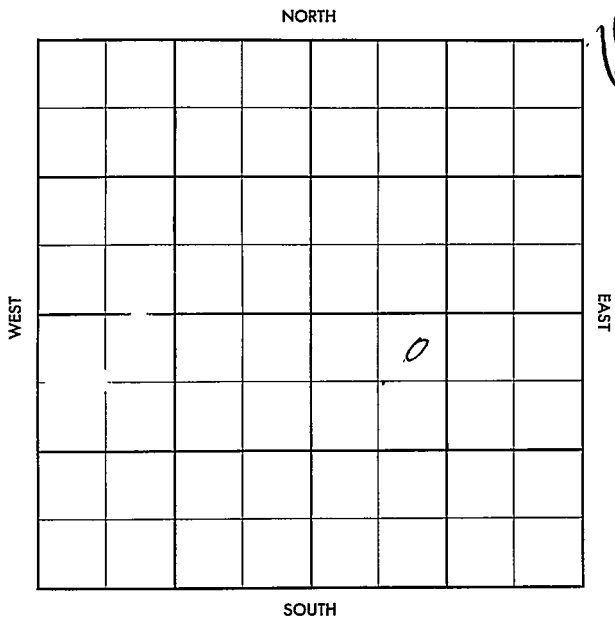

No. County Map

County Dickinson Elev. _____
 Sec. 29 Twp. 16 Rge. 4E
 Company Augusta Oil Co.
 Farm Name H. Riffel No. 1

TOPS	DEPTH	LOG.	DATUM	Loc. in Sec.								
Anb.				NE NW SE								
Ip.												
H.												
Tr.												
Dg.												
Bl.												
L.												
K.C. <u>LKG</u>	<u>1760</u>			Geol. _____								
B.K.C.				Contr. _____								
Ce.				Co. Tools _____								
C.												
M.				Pool _____								
M.	<u>2323</u>			Lost Spgs _____								
K.				NW								
Mz.				<table border="1"> <tr> <td colspan="2">COMPLETE</td> </tr> <tr> <td></td> <td></td> </tr> <tr> <td></td> <td></td> </tr> <tr> <td></td> <td></td> </tr> </table>	COMPLETE							
COMPLETE												
V.												
S.												
S.												
A.												
R.												
PE.												
G.												
TD.	<u>2328</u>			OCT 17 '56								

Date Comm. 9-13-56
 8" @ 100 w/80, 5" @ 2324 9.27.56 ✓

OCT 3 '56 DD 2348 TD FU 600'
oil + 400' SW POP. OCT 10 '56 OCT 17 '56
P. 25 Bopd + 30 Bwopd.