


Map No. KANSAS Sec. 26 Twp. 16 R. 3E

Well No. 1-Morgan Farm

Prairie Oil Co. Company

NORTH

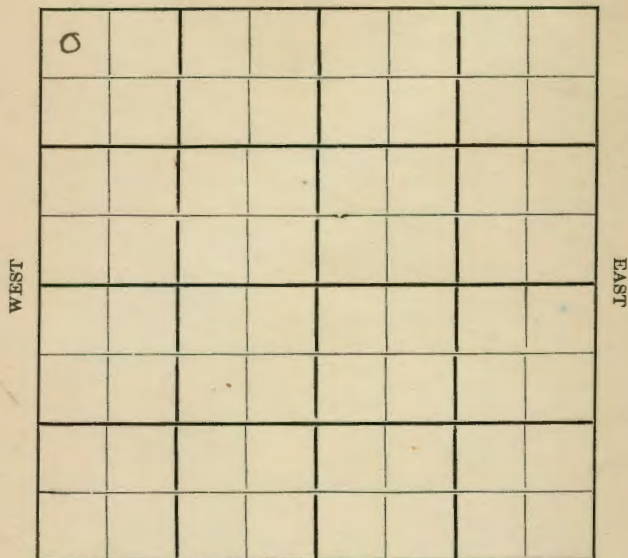

SOUTH

Location
Drilling Remarks

Rig Up
Drilling Remarks

RECORD

Cased in ft.
Sand
Gas
Oil
Total Depth

PRODUCTION

1st 24 hrs. Nat.
1st 24 hrs. after shot
Gas cu. ft.
Dry Hole
Abandoned


Dickinson
FORM 252A-5M-12-28-PETROL

Map No. KANSAS Sec. 26 Twp. 16 R. 3E

Well No. 1-Morgan Farm

Prairie Oil Co. Company

NORTH

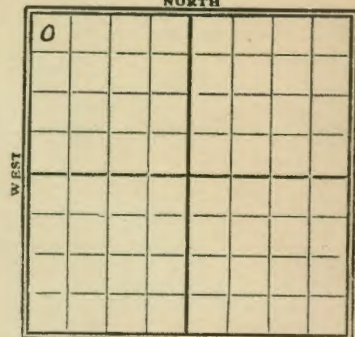

SOUTH

330 Ft. from N. Line

_____ Ft. from S. Line

_____ Ft. from E. Line

330 Ft. from W. Line

1929

Date

REPORT

5/1 Location
5/8 Rig
5/15
5/22 Rig up
5/29 Drly at 545'
6/5 " 1135'
6/12 " 1400'
6/19 " 1450'
6/26 " 1550'
7/2 " 1790'
7/10 " 2070'
7/17 Top chat 2423'
July 6" csg.
7/24 Base line 2585'
drly 2666'
7/31 " 2730'
8/17 Viola 2744-47' HFW
drly 2820'
8/14 " 2930'
8/21 " 2940'
8/28 UR 5"-2965'
(over)

9/4- 5"-2970' HFW 3085

dry 3110'

9/11- SD 3150'

9/18- Top chat 2423

Base line 2585'

Viola 2744-47

had HFW

T.D. 3150'

Dry & Abandon

25 *Dickinson*
 Map No. **KANSAS** Sec. *76* Twp. *16* R. *3*^E
 Well No. *1 Morgan*
Prairie Oil & Gas Co Company
 Contractor

COMPLETE

SECTION PLAT

330 Ft. from N. Line
 Ft. from S. Line
 Ft. from E. Line
330 Ft. from W. Line

ABANDONED

Location.....

Rig up.....

Drilling and Remarks:

Top Chat 7473
Base Line 7585
Viola 7744-47 H&W

RECORD

Cased.....in.,ft.
 Sand.....
 Gas.....
 Oil.....
 Total Depth *3150*

PRODUCTION

1st 24 hrs. Nat.....
 1st 24 hrs. after shot.....
 Gas.....Cu. Ft.
 Dry Hole ☒
 Abandoned.....

Date

SEP 18 1929 **CHAS. L. SHERWOOD**
 192.....Scout

Dickinson
 Map No. **KANSAS** Sec. *76* Twp. *16* R. *3*^E
 Well No. *Morgan*
Prairie Oil & Gas Co Company
 Contractor

FIRST REPORTS

SECTION PLAT

330 Ft. from N. Line
 Ft. from S. Line
 Ft. from E. Line
330 Ft. from W. Line

Location.....

Rig up.....

Drilling and Remarks:

RECORD

Cased.....in.,ft.
 Sand.....
 Gas.....
 Oil.....
 Total Depth.....

PRODUCTION

1st 24 hrs. Nat.....
 1st 24 hrs. after shot.....
 Gas.....Cu. Ft.
 Dry Hole.....
 Abandoned.....

Date

MAY 1 1929 **CHAS. L. SHERWOOD**
 192.....Scout