


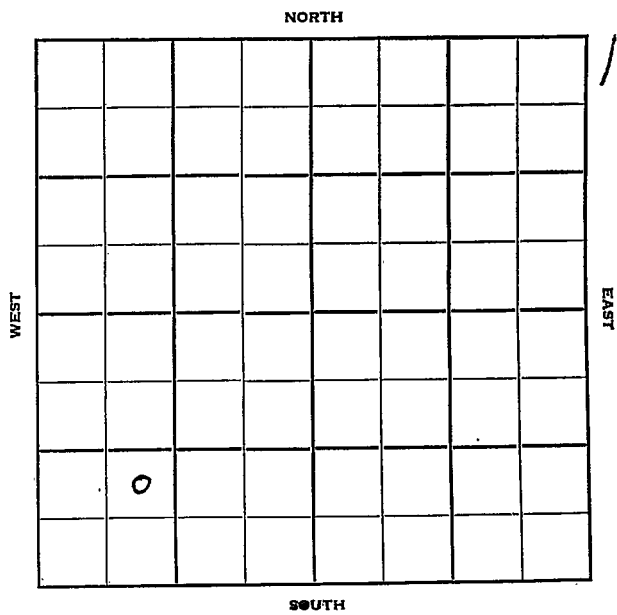

Section 30 Township 16 Range 6-E

Well No. #1 King

Company Atkinson Bros etal



Sec. 30 Twp. 16 R. 6E

Well No. #1 King Farm

Atkinson Bros. et al Company


Wildcat Contractor

Ft. from N. Line

990' Ft. from S. Line

Ft. from E. Line

990' Ft. from W. Line

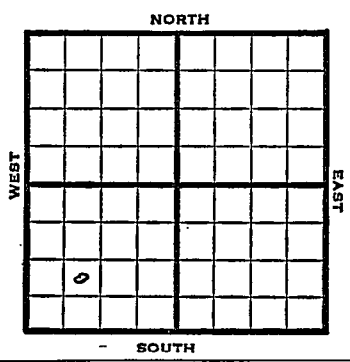

NE SW SW

1950 Elev. - REPORT

11/15 Cellar & Pits
 12/6 D&A TD 2434
 Miss 2165 Kinderhook 2284
 Hunton 2427-34 TD D&A

ABANDONED

2427
 2165

 262

NOV 17 1950

Scout Cards
Land Small Map
Land Wall Map
.....
.....
Pierce Map
Misc.

DEC 12 1950

Scout Cards
Land Small Map
Land Wall Map
Tracings
France Map
Pierce Map
.....
.....

Orig. Data