


Franklin

Form 51-5M-2-29-34703

Map No. KANSAS Sec. 30 Twp. 16 R. 17E

Well No. 1- Huddleston Farm
Gilder & Whiteside Company

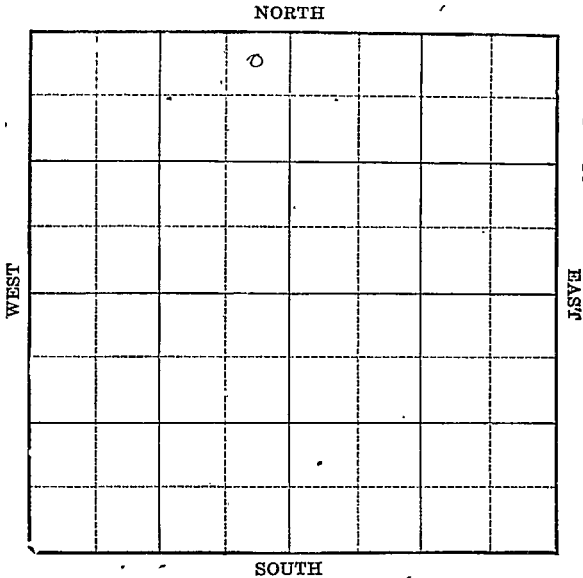

Location _____

Drilling Remarks _____

Rig Up _____

Drilling Remarks _____

RECORD

Cased _____ in. _____ ft.

Sand _____

Gas _____

Oil _____

Total Depth _____

PRODUCTION

1st 24 hrs. Nat. _____

1st 24 hrs. after shot _____

Gas _____ cu. ft. _____

Dry Hole _____

Abandoned _____

Franklin

FORM 252A-5M-8-30-PETROL

Map No. KANSAS Sec. 30 Twp. 16 R. 17E

Well No. 1 - Fuddaleston Farm
Fields & Whiteside Company

NORTH

250 Ft. from N. Line


_____ Ft. from S. Line

250 Ft. from E. Line

_____ Ft. from W. Line

WEST

EAST

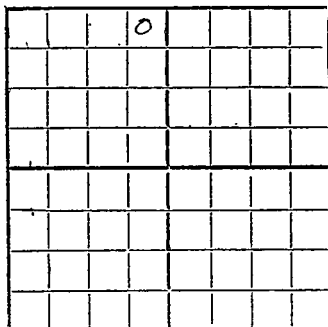

SOUTH

Date

REPORT

8/5

Machine

8/12

8/19

8/26

9/2

9/9

9/16

9/23

Drlg 1150'

FTD. 1255

Dry & Abandon

Franklin

Map No. **KANSAS** Sec. 30 Twp. 16 R. 17 ^EWell No. 1 HuesleatonFrieser & White side Company

Contractor

COMPLETED

250 Ft. from N. Line

Ft. from S. Line

250 Ft. from E. Line

Ft. from W. Line

SECTION PLAT

	o		

ABANDONED

Location

Rig up

Drilling and Remarks:

RECORD

Cased in, ft.

Sand

Gas

Oil

Total Depth 1255

PRODUCTION

1st 24 hrs. Nat.

1st 24 hrs. after shot

Gas Cu. Ft.

Dry Hole. ✓

Abandoned. ✓

Date

SEP 23 1931

CHAS. L. SHERWOOD

192

Scout

Franklin

Map No. KANSAS Sec. 30 Twp. 16 R. 17 ^EWell No. 1 HuddelstonFielder & Whiteside Company

Contractor

FIRST REPORTS

SECTION PLAT

750 Ft. from N. Line

Ft. from S. Line

750 Ft. from E. Line

Ft. from W. Line

	0		

Location MachineRig up Machine

Drilling and Remarks:

RECORD

Cased.....in.,ft.

Sand.....

Gas.....

Oil.....

Total Depth.....

PRODUCTION

1st 24 hrs. Nat.....

1st 24 hrs. after shot.....

Gas.....Cu. Ft.

Dry Hole.....

Abandoned.....

Date

AUG 5 1931 CHAS. L. SHERWOOD

192

Scout