

Morris

KANSAS

SECTION 31 TOWNSHIP 16 RANGE 5E

WELL NO. #1 Youtse

COMPANY Sunflower Drlg. Co.


NORTH

*NW*  
SW SW SW

13

WEST

EAST

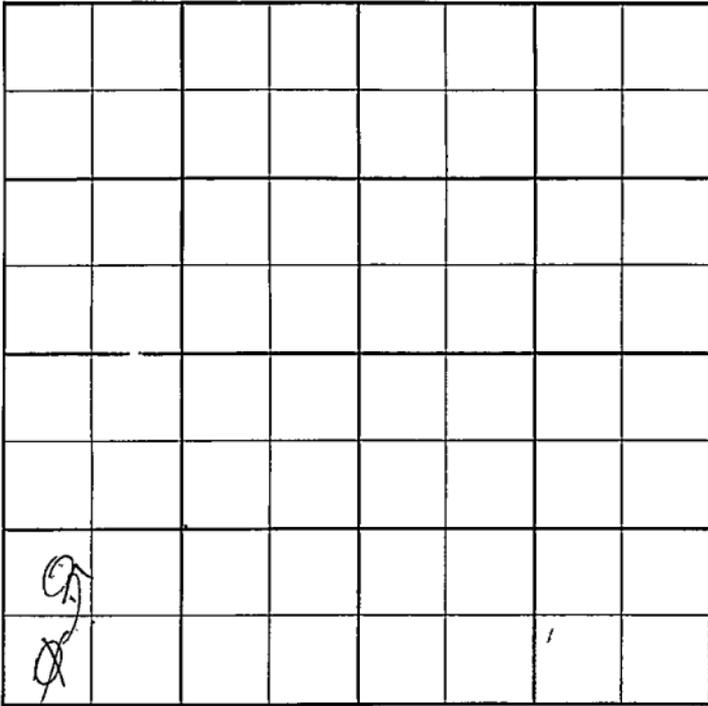

SOUTH

(No County Map)

County Morris Elev. \_\_\_\_\_  
 Sec. 31 Twp. 16 Rgs. 5E  
 Company Sunflower Drilg. Co.  
 FarmName Youtse No. 1

TOPS	DEPTH	LOG	DATUM	Loc. in Sec. _____
Anh.				SW SW SW
Tp.				
H.				
Tr.				
Dg.				
Bl.				
L.				Geol. _____
K.C.				Contr. _____
B.K.C.				<u>Sunflower Tl</u>
Ce.				
C.				Pool _____
M.	<u>2263</u>			<u>Lost Springs</u>
M.				
K.				
Mz.				
Mo.				
V.				
S.				
S.				
A				
R.				
PE				
G.				
T.D.	<u>2276</u>			

FIRST REPORT  
 APR 20 57

Date Comm. 3-13-57

1" @ 2270, WOCT

Co.  
 No.  
 Sec.  
 T.  
 R.

# CORRECTION

FORM 513 SUNRAY

(No County Map)

County Morris Elev. 1443  
 Sec. 31 Twp. 16 Rge. 5E  
 Company Sunflower Drlg. Co.  
 Farm Name Youtse No. 1

TOPS	DEPTH	LOG	DATUM	Loc. in Sec.
Anh.				SW SW SW NW
TP.				
H.				
Tr.				
Dg.				
Bl.				
L.				Geol. _____
K.C.				Contr. _____
B.K.C.				Sunflower Tl
Ce.				
C.				
M.	2263			Pool
M.				Lost Springs
K.				
Mz.				
Mo.				
V.				
Sj.				
S.				
A.				
R.				
Pe.				
G.				
TD.	2276			COMPLETE

Date Comm. 3-13-57

4" @ 2270, WOCT MAR 27 '57 DD APR 3 '57

DD 2300 550 PB 2290

Frac \$ 1 Bopk + 2 Bwpl

est P. 20 Bopd + 45 Bwpl

est grav. 37°

Co.

St.

No.

Sec.

T.

R.