


KANSAS

Morris

Section 31 Township 16 Range 6-E ✓

Well No. #1 Andrews

Company Atkinson Bros et al.

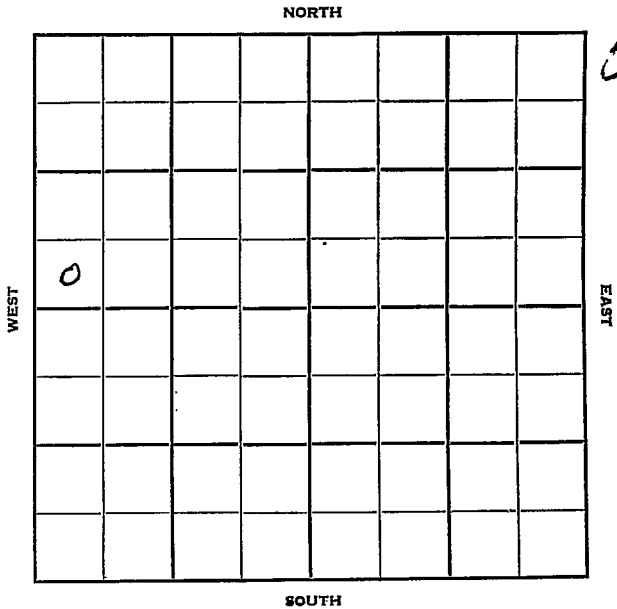

Morris KANSAS

Sec. 31 Twp. 16 R. 6E ✓

Well No. #1 Andrews Farm

Atkinson Bros. et al Company

Murfin Drlg. -Contr. Contractor


         Ft. from N. Line

330' Ft. from S. Line

         Ft. from E. Line

330' Ft. from W. Line

SW SW NW

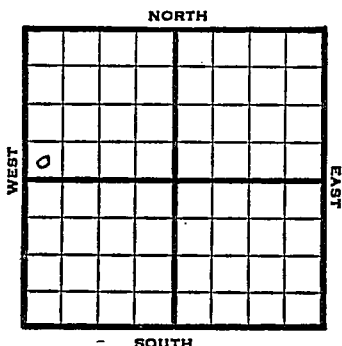

1950


Elev. 1430' REPORT

11/1 Set surface

11/29 D&A TD 2207  
8-5/8" @ 125' Miss 2214-50  
5" @ 2146  
TD 2207 D&A

**ABANDONED**


County Morris State Kansas  
 Sec. 31 (Blk. Twp.) 16 (Sur. Rge.) 6E Map No.  
 Operator Atkinson Bros. et al.  
 Well No. 1 Farm Andrews  
 Elev. \_\_\_\_\_ Location SW SW NW

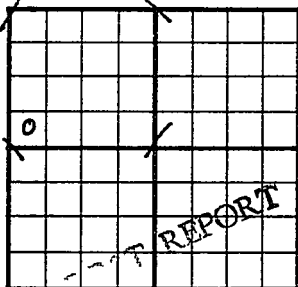

330 Ft. From S Line NW  
330 Ft. From W Line Quarter  
 1st. Report NOV 1 1950  
 Completion \_\_\_\_\_  
 Remarks \_\_\_\_\_  
Murfin Drlg. - Contr.  
 Spudding Date \_\_\_\_\_

Drlg. Data 3 Mile Creek Pool  
Set surface

J. E. TYRA

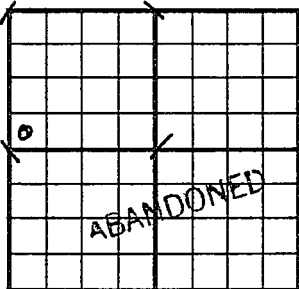County Morris State KansasSec. 31 (Blk.  
Twp.) 16 (Sur.  
Rge.) 6E Map No.Operator Atkinson Bros. etal.Well No. 1 Farm AndrewsElev. 1430 Location SW SW NW330 Ft. From S Line NW330 Ft. From W Line Quarter1st. ReportCompletion NOV 29 1950Remarks 3 mile Creek PoolIngling - Contr.Spudding DateDrlg. Data D & A TD 22078 5/8" @ 125 Miss. 2214-50 5" @ 2146TD 2207 D & A

J. E. TYRA