


Map No. KANSAS Sec. 31 Twp. 16 R. 10^E
 Well No. 1- Allison Farm
Gordon & Stoots Company

NORTH

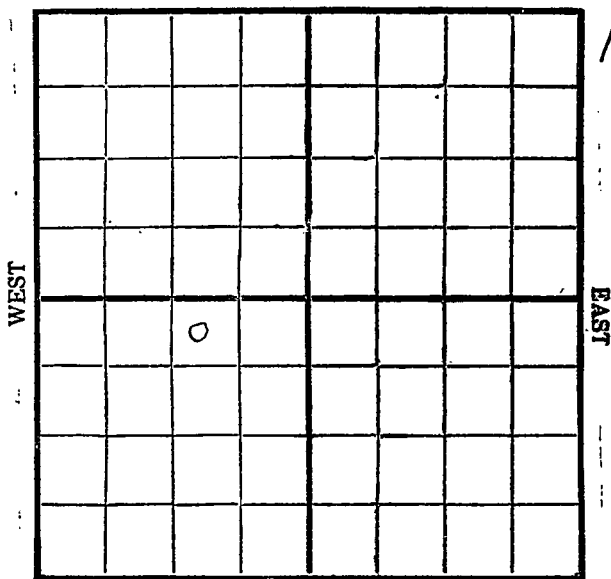

SOUTH

Location _____

Drilling Remarks

Rig Up _____

Drilling Remarks

RECORD

Cased _____ in. _____ ft.

Sand _____

Gas _____

Oil _____

Total Depth _____

PRODUCTION

1st 24 hrs. Nat. _____

1st 24 hrs. after shot _____

Gas _____ cu. ft.

Dry Hole _____

Abandoned _____

Map No. KANSAS Sec. 31 Twp. 16 R. 10^E


Well No. 1- Allison Farm
Tordon & Stooter Company

250 Ft. from N. Line

 Ft. from S. Line

1120 Ft. from E. Line

 Ft. from W. Line

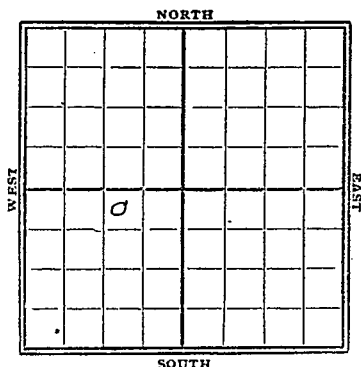

1929

Date

REPORT

9/11 Machine
9/18 Dry 450'
9/25 TD. 500'
Dry & Abandon

28 KANSAS Sec. 31 Twp. 16 R. 10^E

Well No. 1 allison
Gordon & Staats Company

Contractor

FIRST REPORTS

250 Ft. from N. Line

_____ Ft. from S. Line

1120 Ft. from E. Line

_____ Ft. from W. Line

SECTION PLAT

	0		

Location _____

Rig up Machine

Drilling and Remarks:

RECORD

Cased _____ in., _____ ft.

Sand _____

Gas _____

Oil _____

Total Depth _____

PRODUCTION

1st 24 hrs. Nat. _____

1st 24 hrs. after shot _____

Gas _____ Cu. Ft.

Dry Hole _____

Abandoned _____

Date

SEP 11 1929

CHAS. L. SHERWOOD

19

Scout

Map No. KANSAS Sec. 31 Twp. 16 R. 10

Well No. 281 allison

Gordon & Statts Company

Contractor

COMPLETE

SECTION PLAT

	o		

750 Ft. from N. Line

_____ Ft. from S. Line

1170 Ft. from E. Line

_____ Ft. from W. Line

ABANDONED

RECORD

Location _____

Cased _____ in., _____ ft.

Rig up _____

Sand _____

Drilling and Remarks:

Gas _____

Oil _____

Total Depth 500

PRODUCTION

1st 24 hrs. Nat. _____

1st 24 hrs. after shot _____

Gas _____ Cu. Ft.

Dry Hole ☒

Abandoned ☒

Date

SEP 25 1929

19

CHAS. L. SHERWOOD

Scout