


Dickinson

KANSAS

SECTION 32 TOWNSHIP 16 RANGE 4E

WELL NO. #1 H. Helbach

COMPANY Augusta Oil

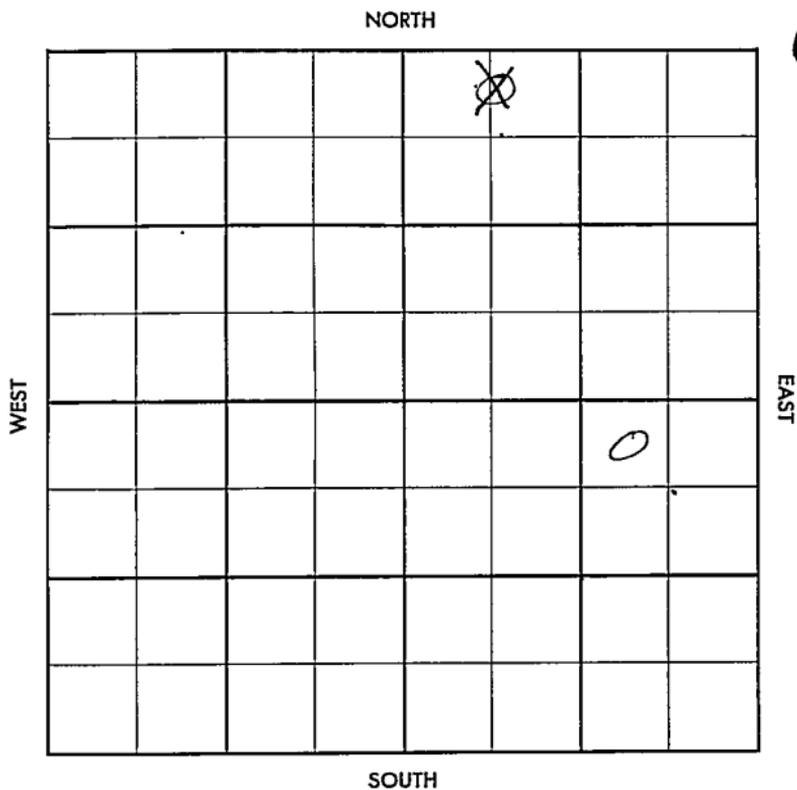

(No County Map)

County Dickinson Elev. _____
 Sec. 32 Twp. 16 Rge. 1E
 Company Augusta Oil
 FarmName H. Helbach No. 1

TOPS	DEPTH	LOG	DATUM
Anb.			
Tp.			
H.			
Tr.			
Dg.			
Bl.			
L.			
K.C.			
B.K.C.			
Ce.			
C.			
M.			
M.			
K.			
Mz.			
Me.			
V.			
S.			
S.			
A.			
R.			
PE.			
G.			
T.D.			

Loc. in Sec. C N $\frac{1}{2}$ NW NE


Geol. _____

Contr. _____

Co. tools

Pool _____

NW Lost Springs

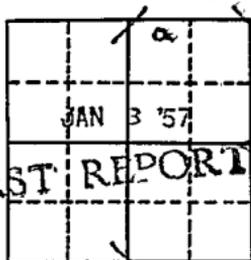

Date Comm. 12-29-56

8" @ 102/75 drlg. 1575

Co.

Loc.

No.

Sec.

T.

R.

CORRECTION

FORM 513 SUNRAY

No County Map

County Dickinson Elev. 1437 DF
 Sec. 32 Twp. 16 Rge. 4E
 Company Augusta Oil
 Farm Name H. Helbach No. 1

TOPS	DEPTH	LOG	DATUM	Location Sec.
Anh.				GNW NW NE NW NE SE
TP.				
H.				
Tr.				
Dg.				
Bl.				
L.				Geol. _____
K.C.				Contr. _____
B.K.C.				
Ce.				Co. tools _____
C.				
M.	2337			Pool _____
M.				NW Lost Spr
K.				
Mz.				
Mo.				
V.				
S.				
S.				ABANDONED X
A.				
R.				
PE.				
G.				JAN 9 '57
T.D.	2403			

Date Comm. 12-29-56

8" @ 102/75 drlg. 1575 JAN 7

N.S. N. Test

D&A