


KANSAS

Dickinson

Section 32 Township 16 Range 4E

Well No. 2 Holback

Company Hutchinson Oil & Gas  
Lost Spring Pool

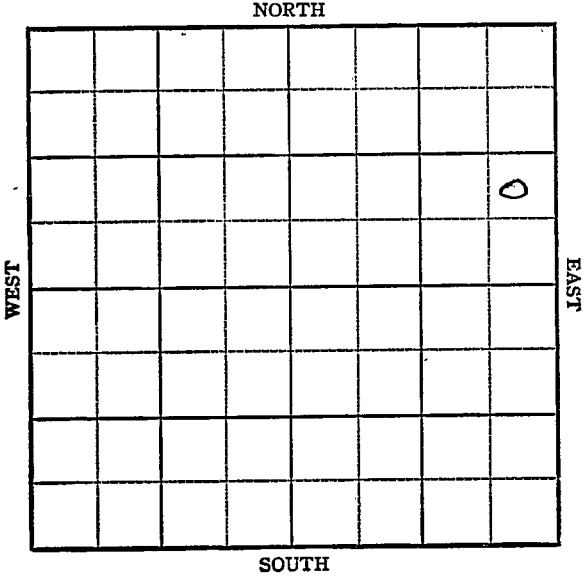

Sec. 32 Twp. 16 R. 4E

Well No. 2 Holback Farm

Hutchinson Oil & Gas Company

**Lost Spring Pool**


\_\_\_\_\_ Ft. from N. Line

990 Ft. from S. Line

330 Ft. from E. Line

\_\_\_\_\_ Ft. from W. Line

NE SE NE

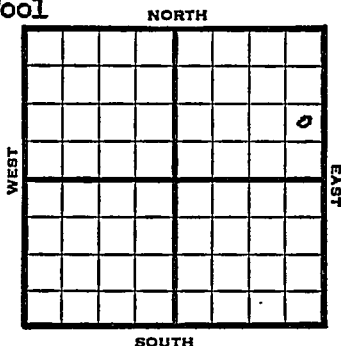

1948 REPORT

11/17	R U R
11/23	8" @ 78' Drlg 2058'
11/30	Mississippi 2317-18' TD 2318'
12/8	5" @ 2318 TD 2366' Miss 2317' Aband.
<b>ABANDONED</b>	

Map No. \_\_\_\_\_ Sec. 32 Twp. 16 R. 4E

Well No. 2 Holback

Hutchinson Oil & Gas Company

**FIRST REPORT**

Contractor \_\_\_\_\_

NE SE NE

**SECTION PLAT**

\_\_\_\_\_ Ft. from N. Line

990 Ft. from S. Line

330 Ft. from E. Line

\_\_\_\_\_ Ft. from W. Line

			o

Dickinson County

Location \_\_\_\_\_

Rig up \_\_\_\_\_

Drilling and Remarks:

R U R

**RECORD**

Cased \_\_\_\_\_ in., \_\_\_\_\_ ft.

Sand \_\_\_\_\_

Gas \_\_\_\_\_

Oil \_\_\_\_\_

Total Depth \_\_\_\_\_

**PRODUCTION**

1st 24 hrs. Nat. \_\_\_\_\_

1st 24 hrs. after shot \_\_\_\_\_

Gas \_\_\_\_\_ Cu. Ft.

Dry Hole \_\_\_\_\_

Abandoned \_\_\_\_\_

Date

NOV 17 1948 19

S. I. LEWIS Scout

