

Sec. 32 Twp. 16 R. 4E

Well No. #1 Holbach Farm


Hutchinson Oil & Gas Company
Lost Spring

 Ft. from N. Line

330 Ft. from S. Line

330 Ft. from E. Line

 Ft. from W. Line

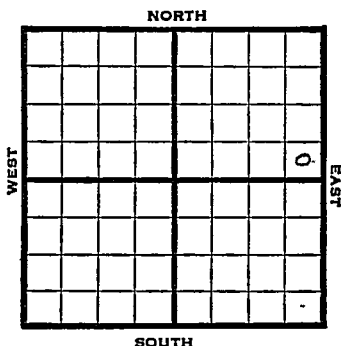

SE NE

1948 Elev. 1426' REPORT

- 6/1 8" @ 96'
Drlg. 1500'
- 6/9 Miss 2328-29
TD 2329'
5" @ 2329'
RUST
- 6/16 "
- 6/23 "
- 6/29 TD 2350'
- 7/8 Miss 2328'
5" @ 2329'
Pump 50 oil Pot.
Gr. 38°
TD 2350'

COMPLETED

Map No. _____ Sec. 32 Twp. 16 R. 4E

Well No. 1 Holbach

Hutchinson Oil & Gas Company

FIRST REPORT

Contractor

SE NE

SECTION PLAT

_____ Ft. from N. Line

330 Ft. from S. Line

330 Ft. from E. Line

_____ Ft. from W. Line

Dickinson County

Location _____

Rig up _____

Drilling and Remarks:

8" @ 96

drlg. 1500

RECORD

Cased _____ in., _____ ft.

Sand _____

Gas _____

Oil _____

Total Depth _____

PRODUCTION

1st 24 hrs. Nat. _____

1st 24 hrs. after shot _____

Gas _____ Cu. Ft.

Dry Hole _____

Abandoned _____

Date

JUN 1 1948

S. J. LEWIS Scout

Map No. 26 Sec. 32 Twp. 16 R. 4E

Well No. 1 Holbach

Hutchinson Oil & Gas Company

COMPLETE

Contractor

SE NE

E11426
SECTION PLAT

_____ Ft. from N. Line

330 Ft. from S. Line

330 Ft. from E. Line

_____ Ft. from W. Line

			5

Dickinson County

Location _____

Rig up _____

Drilling and Remarks:

Misc 2325
5" C 2329
Pump 50 oil Pat

38° S

RECORD

Cased _____ in., _____ ft.

Sand _____

Gas _____

Oil 6.5

Total Depth 2350

PRODUCTION

1st 24 hrs. Nat. _____

1st 24 hrs. after shot _____

Gas _____ Cu. Ft.

Dry Hole _____

Abandoned _____

Date

JUL 8 1948 19

S. J. LEWIS Scout