

KANSAS

Dickinson

Section 33 Township 16 Range 4E

Well No. 1 Daetwiler SWD (*Daetweiler*)


Company Hutchinson Oil & Gas

Lost Spring Pool

NORTH

WEST

EAST

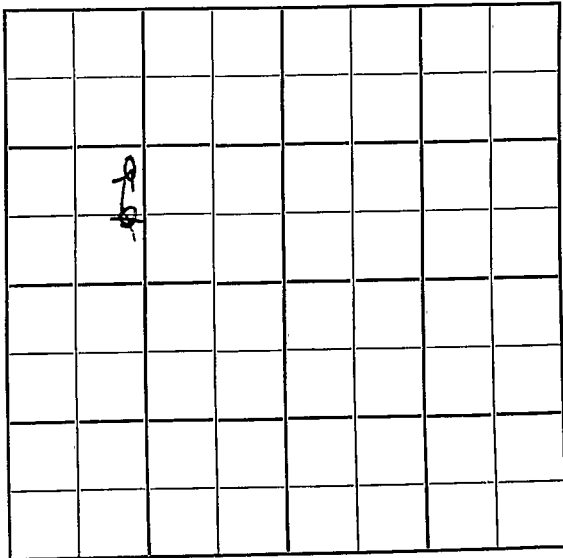

SOUTH

KANSAS

Dickinson

Sec. 33 Twp. 16 R. 4E ✓

Well No. #1 Daetwiler SWD Farm

Hutchinson Oil & Gas

Company

Lost Spring Pool

Ft. from N. Line

990


~~660~~

Ft. from S. Line

Ft. from E. Line

1240

Ft. from W. Line

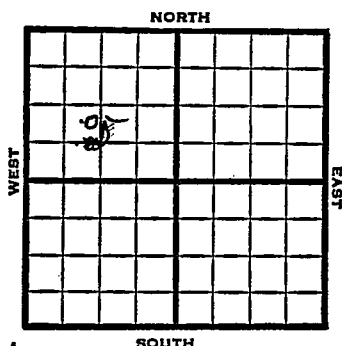

~~C E L SWD~~
C N L S 1/2 NW

1949 Elev 1385' REPORT

4/20	8" @ 80'	
	Drlg. 1345'	
4/27	Miss 2285'	
	Hunton 2569'	
	Drlg 2580'	
5/4	Viola 2764'	
	Simpson 2850'	
	Arb. 2929'	
	Granite 3110'	
	TD 3110'	
	5" @ 2940'	
5/10	"	
5/18	TD 3114'	
	Granite 3110'	
	5" @ 2940'	
	SWD	
	Aband.	

$$\begin{array}{r} 2569 \\ 2285 \\ \hline 284 \end{array}$$

ABANDONED

Map No. _____ Sec. 33 Twp. 16 R. 4E

Well No. 1 Daetwiler SWD

Hutchinson Oil & Gas Company

FIRST REPORT

Contractor

C E L SW NW

SECTION PLAT

0			

Ft. from N. Line

660
Ft. from S. Line

Ft. from E. Line

1240
Ft. from W. Line

Dickinson County

Location _____

Rig up _____

Drilling and Remarks:

8" @ 80

drlg. 1345

RECORD

Cased _____ in., _____ ft.

Sand _____

Gas _____

Oil _____

Total Depth _____

PRODUCTION

1st 24 hrs. Nat. _____

1st 24 hrs. after shot _____

Gas _____ Cu. Ft.

Dry Hole _____

Abandoned _____

Date

APR 20 1949

19

S. J. LEWIS

Scout

Map No. K26 Sec. 33 Twp. 16 R. 4E

Well No. 1 Daetwiler SWD

Hutchinson Oil & Gas Company

CORRECTION

Contractor

C N L S $\frac{1}{2}$ NW

SECTION PLAT

 Ft. from N. Line

990 Ft. from S. Line

 Ft. from E. Line

1240 Ft. from W. Line

Dickinson County

Location

Rig up

Drilling and Remarks:

Reported

C E L SW NW

RECORD

Cased in., ft.

Sand

Gas

Oil

Total Depth

PRODUCTION

1st 24 hrs. Nat.

1st 24 hrs. after shot

Gas Cu. Ft.

Dry Hole

Abandoned

Date

MAY 4 1949


19

S. J. LEWIS

Scout

Kansas

Lost Spring

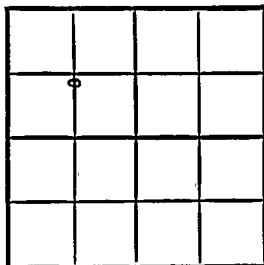Map No. K 26 Sec. 33 Twp. 16 R. 4EWell No. 1 Daetwiler SWDHutchinson Oil & Gas CompanyABANDONED ContractorC N L S $\frac{1}{2}$ NWE 11383
SECTION PLAT Ft. from N. Line990 Ft. from S. Line Ft. from E. Line1240 Ft. from W. LineDickinson CountyLocation Rig up

Drilling and Remarks:

Gravel to 31105" C 2940SWD

RECORD

Cased in., ft.Sand Gas Oil Total Depth 3114

PRODUCTION

1st 24 hrs. Nat. 1st 24 hrs. after shot Gas Cu. Ft.Dry Hole Abandoned

Date

MAY 18 1949

19

S. J. LEWIS

Scout