


Morris

Form 51-5M-2-29-34703

Map No. KANSAS Sec. 33 Twp. 16 R. 7E

Well No. 1-Peterson Farm
Press et al Company

NORTH

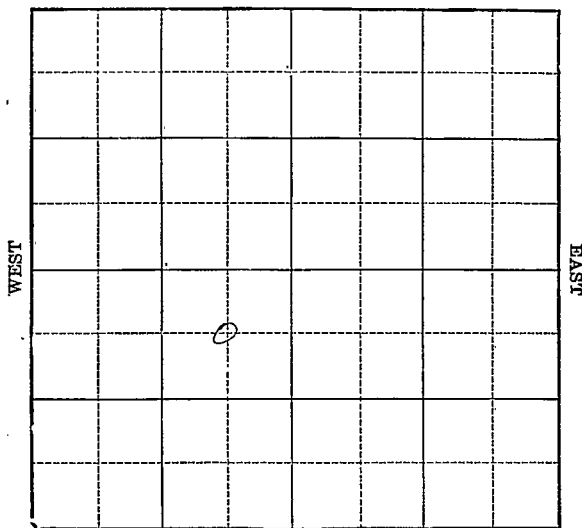

SOUTH

Location

Drilling Remarks

Rig Up

Drilling Remarks

RECORD

Cased _____ in. _____ ft.

Sand _____

Gas _____

Oil _____

Total Depth _____

PRODUCTION

1st 24 hrs. Nat. _____

1st 24 hrs. after shot _____

Gas _____ cu. ft. _____

Dry Hole _____

Abandoned _____

Map No. **KANSAS** Sec. 33 Twp. 16 R. 7E

Well No. 1-Peterson Farm

Dress et al Company


660 Ft. from N. Line

_____ Ft. from S. Line

660 Ft. from E. Line

_____ Ft. from W. Line

1931

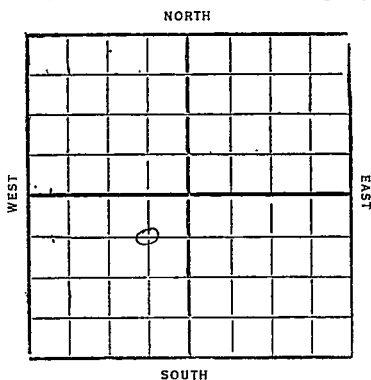

Date

REPORT

10/21

Drill 230'

10/28

11/4

11/10

Drill 250'

11/18

11/24

12/2

SD 700'

12/9

12/16

12/22

12/30

Land 483-491
TD 700

150,000 cu. ft. gas
Comp.

27

Map No. KANSAS Sec. 33 Twp. 16 R. 7 ^EWell No. 1 Peterson
Oress et al Company

Contractor

FIRST REPORTS

660 Ft. from N. Line

..... Ft. from S. Line

660 Ft. from E. Line

..... Ft. from W. Line

SECTION PLAT

Location.....

Rig up.....

Drilling and Remarks:

By 230

RECORD

Cased..... in. ft.

Sand.....

Gas.....

Oil.....

Total Depth.....

PRODUCTION

1st 24 hrs. Nat.....

1st 24 hrs. after shot.....

Gas..... Cu. Ft.

Dry Hole.....

Abandoned.....

Date

OCT 2 1 1931

CHAS. L. SHERWOOD

192

Scout

27 **KANSAS** *Meris* ^E
 Map No. _____ Sec. 33 Twp. 16 R. 7

Well No. 1 *Peterson*
Cress Co _____ Company

 Contractor

COMPLETED

SECTION PLAT

660 Ft. from N. Line

_____ Ft. from S. Line

660 Ft. from E. Line

_____ Ft. from W. Line

	0		

Location _____

Rig up _____

Drilling and Remarks:

RECORD

Cased _____ in.; _____ ft.

Sand 483-491

Gas _____

Oil _____

Total Depth 700

PRODUCTION

1st 24 hrs. Nat. _____

1st 24 hrs. after shot _____

Gas 150,000 Cu. Ft.

Dry Hole _____

Abandoned _____

Date

DEC 20 1931

192 **CHAS. L. SHERWOOD**

Scout