

Sec. 33 Twp. 16 R. 4E

Well No. 2 Daetwiler Farm

Hutchinson Oil & Gas Company

LostSpring Pool


_____ Ft. from N. Line

330 Ft. from S. Line

_____ Ft. from E. Line

990 Ft. from W. Line

SE SW NW

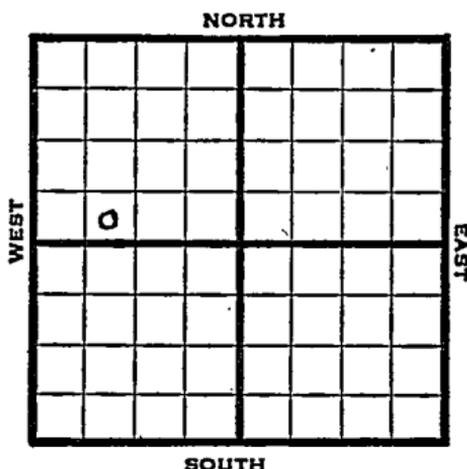

1948 Eli 1403' REPORT

8/25 8" @ 105
Drlg 1815'

9/1 Mississippi 2297'
TD 2298'
5" @ 2297'

9/8 TD 2318' 1500' Oil 1 hr

9/15 Miss 2297'
5" @ 2297'
TD 2318'
Pump 55 oil Pot
36° Gr.
Comp

COMPLETED

Dickinson County Kansas State

Map No. 26 Sec. 33 Twp. 16 R. 4E

Well No. 2 Daetwiler

Hutchinson Oil & Gas Company

COMPLETE

Contractor

SE SW NW

E. 1453
SECTION PLAT

 Ft. from N. Line

330 Ft. from S. Line

 Ft. from E. Line

990 Ft. from W. Line

Lost Spring Pool

Remarks:

Miss 2297

5" @ 2297

NE 23 1/4

Pump 55 oil Prod

36 gals

Date
SEP 1 5 1948

Scout **S. J. LEWIS**