


KANSAS

Section 33 Township 16 Range 4E

Well No. 2 Daetwieler "A" (Daetweiler)

Company Hutchinson Oil & Gas

Lost Spring NORTH

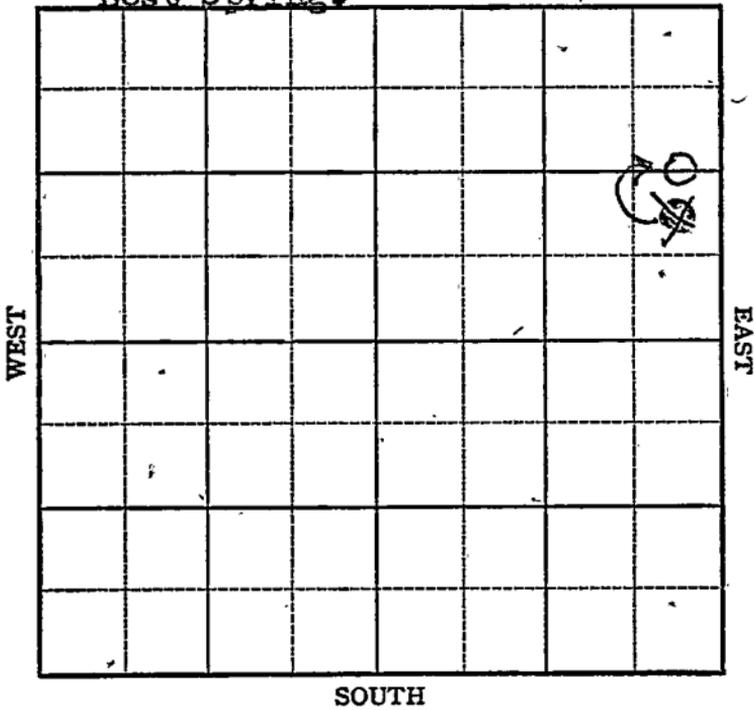

Sec. 33 Twp. 16 R. 4E

Well No. #2 Daetwieler "A" Farm

Hutchinson Oil & Gas Company

Lost Spring


1320 Ft. from N. Line

~~996~~ Ft. from S. Line

330  
~~330~~ Ft. from E. Line

         Ft. from W. Line

C E L N E  
N E S E N E

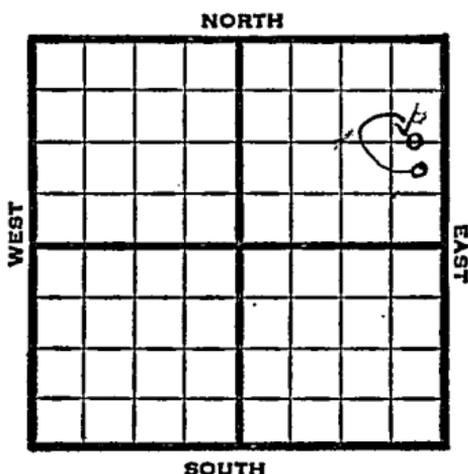

1947

Elev. 1362 REPORT

8/6 Location

8/13 8" @ 105'  
Drlg. 2040'

8/20 Mississippi 2265  
5" @ 2269'  
TD 2290  
350' oil

8/27 -"

9/3 Miss. 2265'  
5" @ 2269'  
Pump 40 Pot  
Gr. 37.6  
TD 2290'

COMPLETED

Kansas Lost Spring

Map No. \_\_\_\_\_ Sec. 33 Twp. 16 R. 4E

Well No. 2 Daetwieler "A"

Hutchinson Oil &amp; Gas Company

## FIRST REPORT

Contractor

NE SE NE

## SECTION PLAT

\_\_\_\_\_ Ft. from N. Line

990 Ft. from S. Line

330 Ft. from E. Line

\_\_\_\_\_ Ft. from W. Line

			Δ

Dickinson County

## RECORD

Location X

Cased \_\_\_\_\_ in., \_\_\_\_\_ ft.

Rig up \_\_\_\_\_

Sand \_\_\_\_\_

Drilling and Remarks:

Gas \_\_\_\_\_

Oil \_\_\_\_\_

Total Depth \_\_\_\_\_

## PRODUCTION

1st 24 hrs. Nat. \_\_\_\_\_

1st 24 hrs. after shot \_\_\_\_\_

Gas \_\_\_\_\_ Cu. Ft.

Dry Hole \_\_\_\_\_

Abandoned \_\_\_\_\_

Date

AUG 6 1947 19 S. J. LEWIS Scout

Map No. 26 Sec. 33 Twp. 16 R. 4E

Well No. 2 Daetwieler

Hutchinson Oil & Gas Company

**CORRECTION** Contractor

C E L NE


SECTION PLAT

1320 Ft. from N. Line

\_\_\_\_\_ Ft. from S. Line

330 Ft. from E. Line

\_\_\_\_\_ Ft. from W. Line

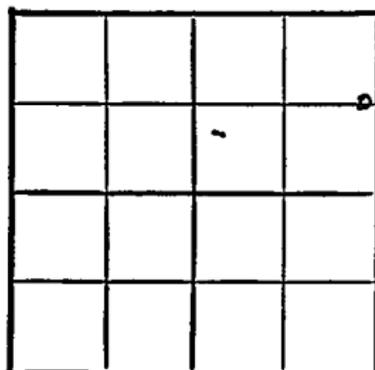

Dickinson County

Location \_\_\_\_\_

Rig up \_\_\_\_\_

Drilling and Remarks:

Reported  
NE SE NE

RECORD

Cased \_\_\_\_\_ in., \_\_\_\_\_ ft.

Sand \_\_\_\_\_

Gas \_\_\_\_\_

Oil \_\_\_\_\_

Total Depth \_\_\_\_\_

PRODUCTION

1st 24 hrs. Nat. \_\_\_\_\_

1st 24 hrs. after shot \_\_\_\_\_

Gas \_\_\_\_\_ Cu. Ft.

Dry Hole \_\_\_\_\_

Abandoned \_\_\_\_\_

Date

AUG 13 1947

19

S. J. LEWIS

Scout

Map No. 26 Sec. 33 Twp. 16 R. 4E

Well No. 2 Daetwieler "A"

Hutchinson Oil & Gas Company

**COMPLETE**

Contractor

C. E. L. NE

*E 1, 1862*  
SECTION PLAT

1320 Ft. from N. Line

         Ft. from S. Line

330 Ft. from E. Line

         Ft. from W. Line


Dickinson County

**RECORD**

Location \_\_\_\_\_

Cased \_\_\_\_\_ in., \_\_\_\_\_ ft.

Rig up \_\_\_\_\_

Sand \_\_\_\_\_

Drilling and Remarks:

Gas \_\_\_\_\_

Oil \_\_\_\_\_

Total Depth 2290

*Miss 2265*

*5' @ 2269*

*Pump 40 ft*

**PRODUCTION**

1st 24 hrs. Nat. \_\_\_\_\_

1st 24 hrs. after shot \_\_\_\_\_

Gas \_\_\_\_\_ Cu. Ft.

Dry Hole \_\_\_\_\_

Abandoned \_\_\_\_\_

Date

SEP 3 1947 19

S. J. LEWIS Scout