FORM 51 25M 3-49 PETROL KANSAS Dickinson

Section 33 Township 16 Range 4E

Well No. 1 Martin

Company W.A. Martin et al

Lost Spring

9

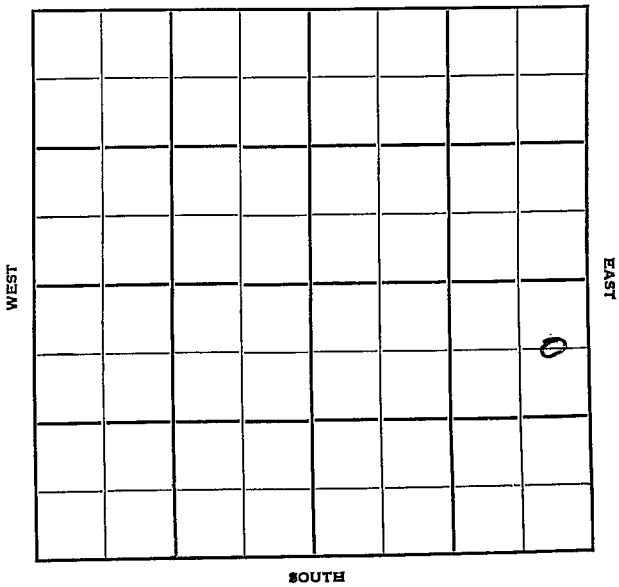

FORM 252-A
5M 10-48 PETROL

Dickinson KANSAS

Sec. 33 Twp. 16 R. 4E

Well No. #1 Martin Farm

W. A. Martin et al Company

Lost Spring (Slusser, Cont.)

660' Ft. from N. Line

Ft. from S. Line

330' Ft. from E. Line

Ft. from W. Line

C E L NE SE

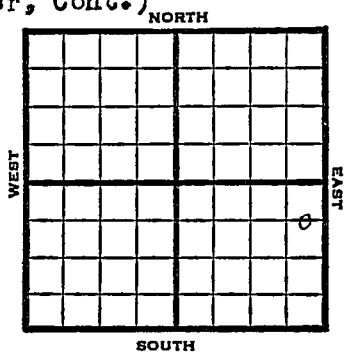

1949	REPORT
8/10	8" @ 85'
	Drlg. 1750'
8/17	"
8/24	TD 2339'
	Miss 2283'
	5"@ 2283'
	Aband.
	ABANDONED

Form 26 200 Bks. 6-49 Petrol

Kansas

Lost Spring

Map No. _____ Sec. 33 Twp. 16 R. 4E

Well No. 1 Martin

W. A. Martin etal. Company

Slusser Contractor

C E L NE SE

FIRST REPORT

SECTION PLAT

660 Ft. from N. Line

Ft. from S. Line

330 Ft. from E. Line

Ft. from W. Line

Dickinson County

Location

Rig up

Drilling and Remarks:

8" @ 85

drlg. 1750

RECORD

Cased _____ in., _____ ft.

Sand

Gas

Oil

Total Depth

PRODUCTION

1st 24 hrs. Nat.

1st 24 hrs. after shot

Gas _____ Cu. Ft.

Dry Hole

Abandoned

Date

AUG 10 1949 19

S. J LEWIS Scout

Form 26 200 Bks. 6-49 Petrol

Lost Spring Pool

Kansas

Map No. K 2 Sec. 33 Twp. 16 R. 4E

Well No. 1 Martin

W. A. Martin etal. Company

ABANDONED

Contractor

C E L NE SE

660 Ft. from N. Line

Ft. from S. Line

330 Ft. from E. Line

Ft. from W. Line

SECTION PLAT

Dickinson County

Location

Rig up

Drilling and Remarks:

Mis 2273

5" C 2273

RECORD

Cased in., ft.

Sand

Gas

Oil

Total Depth 2239

PRODUCTION

1st 24 hrs. Nat.

1st 24 hrs. after shot

Gas Cu. Ft.

Dry Hole

Abandoned

Date

AUG 24 1949 19

S. J. LEWIS Scout