


KANSAS

Map No. _____ Sec. 33 Twp. 16 R. 4EWell No. 1- Reidy Farm _____Watchorn O. & G. Company _____

NORTH

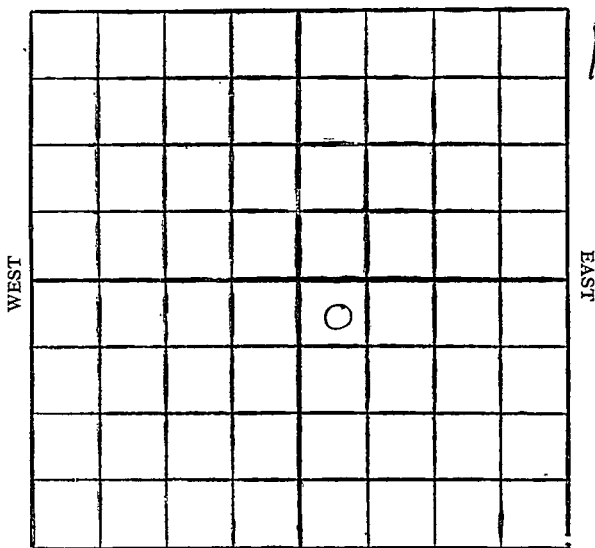

SOUTH

Location _____

Drilling Remarks _____

Rig Up _____

Drilling Remarks _____

RECORD

Cased _____ in. _____ ft.

Sand _____

Gas _____

Oil _____

Total Depth _____

PRODUCTION

1st 24 hrs. Nat. _____

1st 24 hrs. after shot _____

Gas _____ cu. ft.

Dry Hole _____

Abandoned _____

Map No. **KANSAS** Sec. **33** Twp. **16** R. **4**

Well No. **1- Reidy** Farm
Watchorn O & S. Company

NORTH

330 Ft. from N. Line

_____ Ft. from S. Line

_____ Ft. from E. Line

330 Ft. from W. Line

WEST

EAST

SOUTH

1928

Date

REPORT

5/24	Bldg Rig
5/31	Rig
6/7	I
6/14	Drlg 1400
6/21	" 1450
6/28	" 1550
7/6	" 1910
7/13	Fishing 1910
7/19	I
7/26	T.D. 1910 - Skidding rig
8/2	Spudding new hole
8/9	Drlg 900
8/16	" 1120
8/23	" 2260'
8/28	Chat 2328-2400 show oil
	+ HFW Tsg 2451
9/5	Chat 2328-2400
	show oil + HFW
	Line 2612-30
	HFW @ 2628'
	D & A @ 2630
	Aband

Dickinson

KANSAS 33
MAP NO. 33 SEC. 16 TWP. 16 R. 4WELL NO. Wichita

Watchorn Oil & Co

COMPANY

CONTRACTOR

COMPLETED

SECTION PLAT

330

Ft. FROM N. LINE

Ft. FROM S. LINE

Ft. FROM E. LINE

330

Ft. FROM W. LINE

ABANDONED

		0	

LOCATION _____

RIG UP _____

DRILLING AND REMARKS:

Chat 2328-2400'
Show oil & NFW
lime 2612-30'
NFW 2628'

Dra 2630

RECORD

Cased _____ IN. _____ FT.

SAND _____

GAS _____

OIL _____

TOTAL DEPTH 2630

PRODUCTION

1ST 24 HRS. NAT. _____

1ST 24 HRS. AFTER SHOT _____

GAS _____ Cu. Ft.

DRY HOLE ☒ABANDONED ☒

DATE

SEP 5 1928

CHAS. L. SHERWOOD

192

SCOUT

Dickinson
 MAP No. 1 **KANSAS** SEC. 33 TWP. 16 R. 4 **E**
 WELL No. 1 *Beider*
Watchman 8025 Co COMPANY

CONTRACTOR

FIRST REPORTS

SECTION PLAT

330 FT. FROM N. LINE

_____ FT. FROM S. LINE

_____ FT. FROM E. LINE

330 FT. FROM W. LINE

RECORD

LOCATION *Beider*

CASED _____ IN. _____ FT.

RIG UP *Beider*

SAND _____

DRILLING AND REMARKS:

GAS _____

OIL _____

TOTAL DEPTH _____

PRODUCTION

1ST 24 HRS. NAT. _____

1ST 24 HRS. AFTER SHOT _____

GAS _____ CU. FT.

DRY HOLE _____

ABANDONED _____

DATE

MAY 24 1928

CHAS. L. SHERWOOD

192

SCOUT

MAP No. _____ SEC. 33 TWP. 16S R. 4EWELL No. 1 ReiderWatchman

COMPANY _____

CONTRACTOR _____

no wall map

SECTION PLAT

_____ Ft. FROM N. LINE

_____ Ft. FROM S. LINE

_____ Ft. FROM E. LINE

_____ Ft. FROM W. LINE

LOCATION _____

RIG UP _____

DRILLING AND REMARKS:

lost hole
skid rig

RECORD

CASED _____ IN. _____ FT.

SAND _____

GAS _____

OIL _____

TOTAL DEPTH 1910

PRODUCTION

1ST 24 HRS. NAT. _____

1ST 24 HRS. AFTER SHOT _____

GAS _____ CU. FT.

DRY HOLE ✓ABANDONED ✓

DATE

8/8 1928

SCOUT _____