

KANSAS

Dickinson

Section 33 Township 16 Range 4EWell No. 2 ReidyCompany Hodnett & Uhl

Lost Spring

NORTH

WEST

EAST

				0			

SOUTH

10

Dickinson **KANSAS**

Sec. 33 Twp. 16 R. 4E

Well No. #2 Reidy Farm

Hodnett & Uhl

Company


Lost Spring Pool (Uhl, Cont.)

990' Ft. from N. Line

Ft. from S. Line

Ft. from E. Line

330' Ft. from W. Line

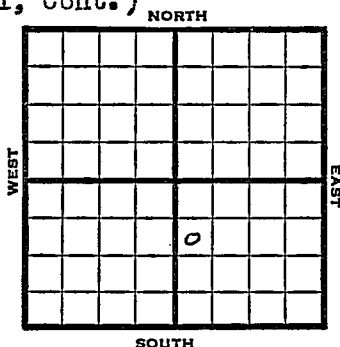

SW NW SE

1949	Elev 1424' REPORT
9/7	8" @ 131'
	Drlg. 581'
9/14	Chat 2325' - 41'
	TD 2341'
	5" @ 2328'
9/21	"
9/28	"
10/5	TD 2421'
	Swb 1 bbl oil / 6 W PH. 4 hrs.
10/12	TD 2421'
	Chat 2325'
	5" @ 2328'
	Pump 24 Oil / W Pot
	36° Gr.
	Comp
	COMPLETED

Map No. _____ Sec. 33 Twp. 16 R. 4E

Well No. 2 Reidy

Hodnett & Uhl Company

Uhl Contractor

SW NW SE


FIRST REPORT SECTION PLAT

990 Ft. from N. Line

_____ Ft. from S. Line

_____ Ft. from E. Line

330 Ft. from W. Line

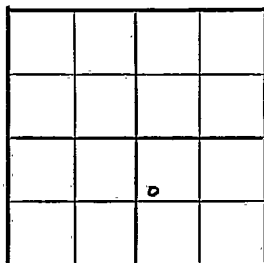

Dickinson County

RECORD

Location _____

Cased _____ in., _____ ft.

Rig up _____

Sand _____

Drilling and Remarks: _____

Gas _____

Oil _____

8" @ 131

Total Depth _____

drlg. 581

PRODUCTION

1st 24 hrs. Nat _____

1st 24 hrs. after shot _____

Gas _____ Cu. Ft.

Dry Hole _____

Abandoned _____

Date

SEP 7 1949 19

S. J. LEWIS

Scout

Map No. _____ Sec. 33 Twp. 16 R. 4E

Well No. 2 Reidy

Hodnett & Uhl Company

COMPLETE

Contractor

SW NW SE


E11424
SECTION PLAT

990 Ft. from N. Line

_____ Ft. from S. Line

_____ Ft. from E. Line

330 Ft. from W. Line

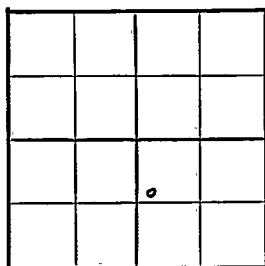

Dickinson County

RECORD

Location _____

Cased _____ in., _____ ft.

Rig up _____

Sand _____

Drilling and Remarks:

Gas _____

Oil _____

Total Depth 2421

PRODUCTION

1st 24 hrs. Nat. _____

1st 24 hrs. after shot _____

Gas _____ Cu. Ft.

Dry Hole _____

Abandoned _____

Chas 2325
5" C 2325
Prod 24 oil + W
Ed.
CP 6 2/2

Date

OCT 12 1949 19

S. J. LEWIS

Scout