


Section 33 ~~34~~ Township 16 Range 4E

Well No. 4 Daetwiler (Daetweiler)

Company Hutchinson Oil & Gas ?

Lost Spring Pool

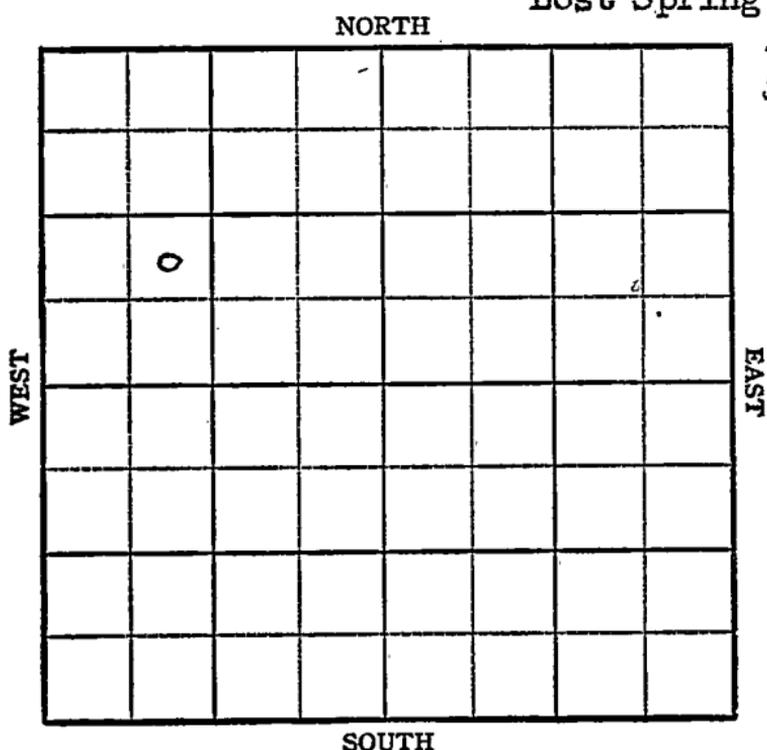

KANSAS

Dickinson



Sec. 33 Twp. 16 R. 4E

Well No. #4 - Daetwiler Farm
Hutchinson Oil & Gas Company

Lost Spring Pool


_____ Ft. from N. Line

990' _____ Ft. from S. Line

_____ Ft. from E. Line

990' _____ Ft. from W. Line

. NE SW NW

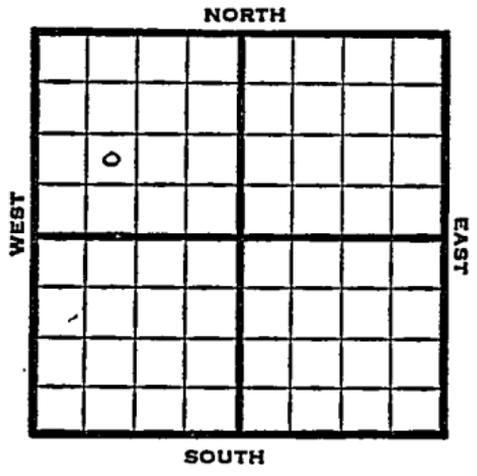

1948

Eli 1398' REPORT

12/15
12/22

RUR
8" @ 85'

12/29

Drlg 1900'
TD 2352'
Miss 2321'
5" @ 2322'
Aband;

ABANDONED

Map No. _____ Sec. 34 Twp. 16 R. 4E

Well No. 4 Daetwiler

Hutchinson Oil & Gas Company

FIRST REPORT

Contractor

NE SW NW

SECTION PLAT

_____ Ft. from N. Line

990 Ft. from S. Line

_____ Ft. from E. Line

990 Ft. from W. Line

o			

Dickinson County

Location _____

Rig up _____

Drilling and Remarks:

R M R

RECORD

Cased _____ in., _____ ft.

Sand _____

Gas _____

Oil _____

Total Depth _____

PRODUCTION

1st 24 hrs. Nat. _____

1st 24 hrs. after shot _____

Gas _____ Cu. Ft.

Dry Hole _____

Abandoned _____

Date

DEC 15 1948 19

S. J. LEWIS

Scout

Map No. 26 Sec. 32 Twp. 16 R. 4E

Well No. 4 Daetwiler

Hutchinson Oil & Gas Company

ABANDONED

Contractor

SE NE NW

E11898
SECTION PLAT

990 Ft. from N. Line

 Ft. from S. Line

330 Ft. from E. Line

 Ft. from W. Line

	o		

Dickinson County

Location

Rig up

Drilling and Remarks:

*Miss 2321
5" @ 2322*

RECORD

Cased in, ft.

Sand

Gas

Oil

Total Depth 2,252

PRODUCTION

1st 24 hrs. Nat.

1st 24 hrs. after shot

Gas Cu. Ft.

Dry Hole

Abandoned

Date

DEC 29 1948 19

S. J. LEWIS Scout