


Section 33 Township 16 Range 4E  
 Well No. 2 Daetwiler (Daetweiler)  
 Company Hutchinson Oil & Gas ?  
 Lost Spring Pool

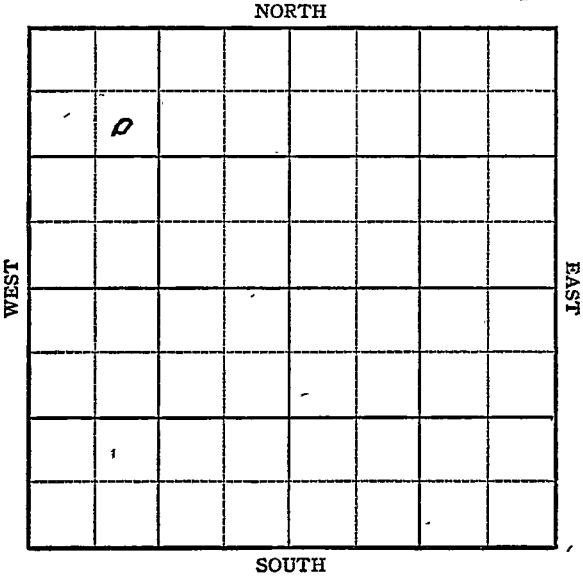

4

WEST

EAST

Sec. 33 **KANSAS** Twp. 16 R. 4E

Well No. #2 Daetwiler Farm

Hutchinson Oil & Gas Company

Lost Spring Pool


990' Ft. from N. Line

\_\_\_\_\_ Ft. from S. Line

\_\_\_\_\_ Ft. from E. Line

990' Ft. from W. Line

SE NW NW

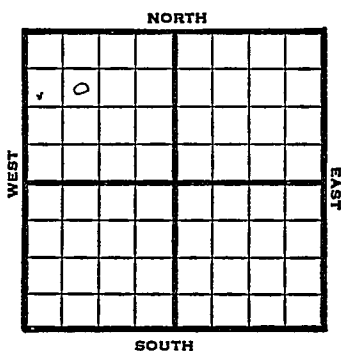

1949

REPORT

1/5 8" @ 80'  
Drlg. 1355'

1/12 Mississippi 2300-01 TD 5" @ 2301

1/19 TD 2313'  
Miss 2300'  
5"@ 2301'  
Pump 50 oil Pot  
38° Gr.  
Comp

**COMPLETED**

Kansas

Map No. \_\_\_\_\_ Sec. 33 Twp. 16 R. 4EWell No. 2 DaetwilerHutchinson Oil & Gas CompanyFIRST REPORT Contractor

SE NW NW

## SECTION PLAT

990 Ft. from N. Line

\_\_\_\_\_ Ft. from S. Line

\_\_\_\_\_ Ft. from E. Line

990 Ft. from W. Line


Dickinson County

Location \_\_\_\_\_

Rig up \_\_\_\_\_

Drilling and Remarks:

8" @ 80

drlg. 1355

## RECORD

Cased \_\_\_\_\_ in., \_\_\_\_\_ ft.

Sand \_\_\_\_\_

Gas \_\_\_\_\_

Oil \_\_\_\_\_

Total Depth \_\_\_\_\_

## PRODUCTION

1st 24 hrs. Nat. \_\_\_\_\_

1st 24 hrs. after shot \_\_\_\_\_

Gas \_\_\_\_\_ Cu. Ft.

Dry Hole \_\_\_\_\_

Abandoned \_\_\_\_\_

Date

JAN 5 1949

19

S. J. LEWIS Scout

Map No. 26 Sec. 33 Twp. 16 R. 4E

Well No. 2 Daetwiler

Hutchinson Oil & Gas Company

COMPLETE Contractor

SE NW NW

SECTION PLAT

990 Ft. from N. Line

\_\_\_\_\_ Ft. from S. Line

\_\_\_\_\_ Ft. from E. Line

990 Ft. from W. Line

o			
,			

Dickinson County

RECORD

Location \_\_\_\_\_

Cased \_\_\_\_\_ in., \_\_\_\_\_ ft.

Rig up \_\_\_\_\_

Sand \_\_\_\_\_

Drilling and Remarks:

Gas \_\_\_\_\_

*Misc 2300*

Oil

*5" @ 2301*

Total Depth 2313

*Run 50 oil Rod*

PRODUCTION

1st 24 hrs. Nat. \_\_\_\_\_

1st 24 hrs. after shot \_\_\_\_\_

Gas \_\_\_\_\_ Cu. Ft.

Dry Hole \_\_\_\_\_

Abandoned \_\_\_\_\_

Date

JAN 19 1949 19

S. J. LEWIS

Scout