

KANSAS


Morris

FORM 51 25M 3-49 PETROL

Section 34 Township 16 Range 5-E

Well No. #1 Peterson

Company Atlas Drlg. Inc.

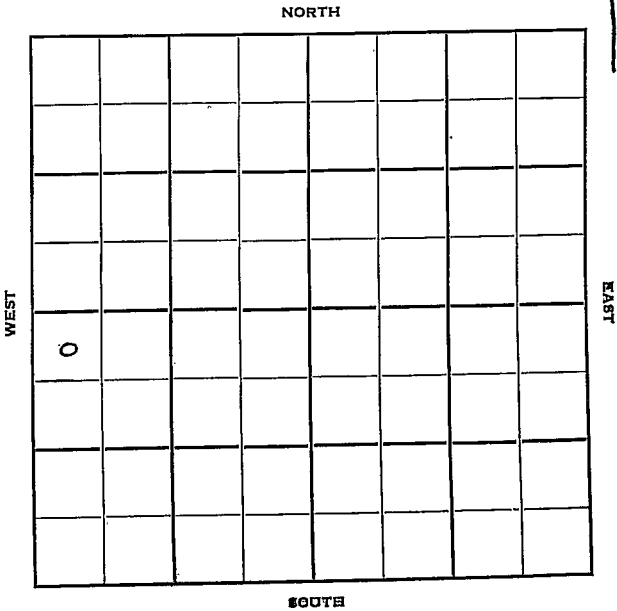

Sec. 34 Twp. 16 R. 5E

Well No. #1 Peterson Farm

Atlas Drlg, Inc. Company

Atlas Drlg. Contr. Contractor

Wildcat


330' Ft. from N. Line

_____ Ft. from S. Line

_____ Ft. from E. Line

330' Ft. from W. Line

NW NW SW

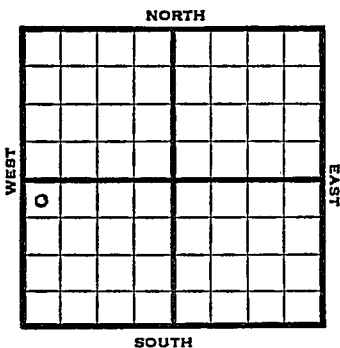

1950

Elev. 1463' REPORT

9/20

Location

10/11

Spud 9-20-50

D&A TD 2344

8" @ 150' Miss 2240-80

SO 2240-50

DST 2240-80 opn 1 hr Rec. 105' ocm

5 1/2" @ 2241 TD 2297 3 bfph 1 go

TD 2344' D&A

ABANDONED

County Morris State Kansas

Sec. 34 (Blk.) 16 (Sur.) 5E Map No.

Operator Atlas Drlg. Inc.

Well No. 1 Farm Peterson

Elev. 1463 Location NW NW SW

ABANDONED

330 Ft. From N Line SW

330 Ft. From W Line Quarter

1st. Report

Completion OCT 11 1950

Remarks Wildcat

Atlas Drlg. - Contr.

Spudding Date 9-20-50

Drlg. Data D & A TD 2344

8" @ 150 Miss. 2240-80 SO 2240-50

DST 2240-80 open 1 hr. Rec. 105' ocm

5½" @ 2241 TD 2297 3 bfph 1 go

TD 2344 D & A