


Section 34 Township 16 Range 5E  
 Well No. 1 Peterson  
 Company C. R. Atkinson et al

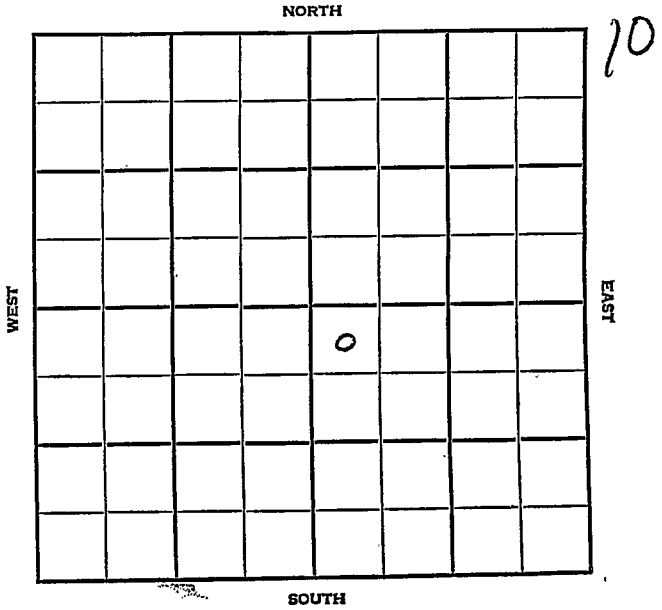

Morris

KANSAS

|      |      |    |
|------|------|----|
| SEC. | TWP. | R. |
| 34   | 16   | 5E |

WELL NO.

#1 Peterson

FARM

COMPANY

C.R. Atkinson et al

CONTRACTOR

Slusser Tools

Wildcat.

330

Ft. from N. Line


Ft. from S. Line

Ft. from E. Line

330

Ft. from W. Line

NW NW SE

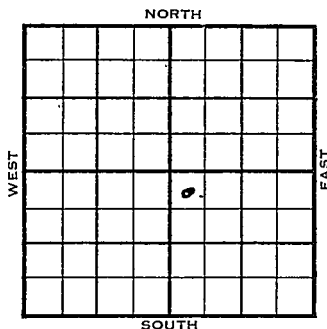

1954

ELEVATION

1435'

REPORT

9/29

Location

10/27

Spud 9-30-54

D &amp; A

TD 2268'

8" @ 132'

Chat 2198'

TD 2199'

4 1/2" @ 2199'


DD 2268'

VSSO

D &amp; A

ABANDONED

# FABEN GILSTRAP

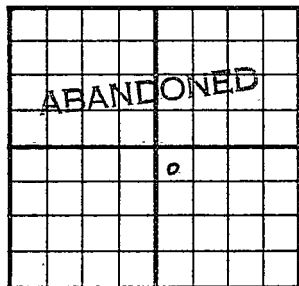County Morris State KansasSec. 34 (Blk.) 16 (Sur.) 5E Map No.Operator C. R. Atkinson et al.Well No. 1 Farm PetersonElev. 1435 Location NW NW SE330 Ft. From N Line SE330 Ft. From W Line Quarter

1st. Report

Completion OCT 27 1954Remarks WildcatSlusser Drlg. - Contr.Spudding Date 9-30-54Drlg. Data D & A TD 22688" @ 132 Chat 2198 TD 2199 4½" @ 2199DD 2268 VSSOD & A

FABEN-OLSTRUP