

Section 34 Township 16 Range 4-E

Well No. #3 Daetwiler (Daetweiler)


Company Veeder Supply ?

NORTH

9

WEST

EAST

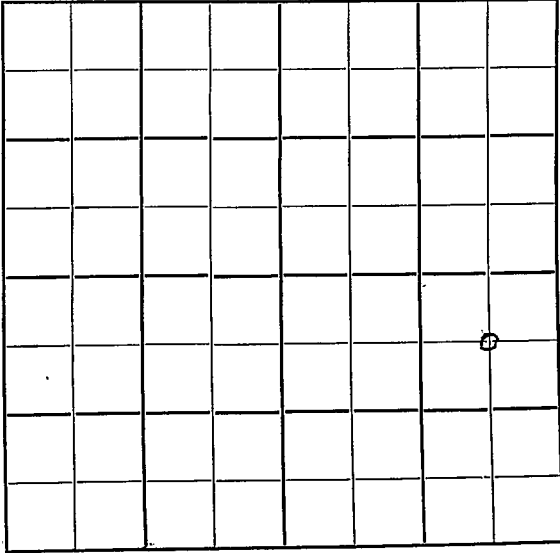

SOUTH

Sec. 34 Twp. 16 R. 4-E ✓

Well No. #3 Daetwiler Farm

Veeder Supply Company

Contractor

Lost Springs


660 Ft. from N. Line

_____ Ft. from S. Line

660 Ft. from E. Line

_____ Ft. from W. Line

C NE SE

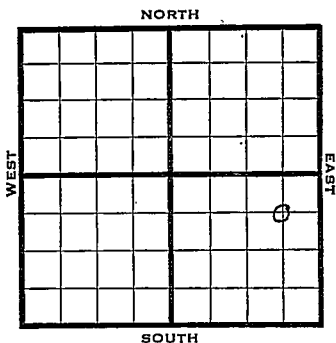

1950

Elev 1438

REPORT

7/12

Location

8/30

8 5/8" @ 131'

Miss 2295

5" @ 2302

TD 2353

D&A

ABANDONED

Map No. _____ Sec. 34 Twp. 16 R. 4EWell No. 3 Daetwiler_____ Veeder Supply _____ Company

_____ Contractor

C NE SE

660 Ft. from N. Line

_____ Ft. from S. Line

660 Ft. from E. Line

_____ Ft. from W. Line

SECTION PLAT

			o

FIRST REPORT

Dickinson County

Location X

Rig up _____

Drilling and Remarks:

RECORD

Cased _____ in., _____ ft.

Sand _____

Gas _____

Oil _____

Total Depth _____

PRODUCTION

1st 24 hrs. Nat. _____

1st 24 hrs. after shot _____

Gas _____ Cu. Ft.

Dry Hole _____

Abandoned _____

Date

JUL 12 1950 19 _____J. E. TYRA Scout

County Dickinson State Kansas

Sec. 34 (Blk. 16) (Sur. 4E) (Twp. 16) (Rge. 4E) Map No.

Operator Veeder Supply

Well No. 3 Farm Daetwiler

Elev. 1438 Location C NE SE

ABANDONED

660 Ft. From N Line SE

660 Ft. From E Line Quarter

Ist. Report

Completion AUG 30 1950

Remarks

Lost Springs Pool

Spudding Date

Drlg. Data D & A TD 2353

8 5/8" @ 131 Miss. 2295 5" @ 2302

TD 2353 D & A