

KANSAS

Dickinson

Section 34 Township 16S Range 4E

Well No. #7 Biehler

Company Hutchinson Oil & Gas

NORTH

WEST

						0	

EAST

SOUTH

8

KANSAS

Dickinson

Sec. 34 Twp. 16 R. 4-E ✓

Well No. #7 Biehler Farm

Hutchinson Oil & Gas Company

Cont Slusser Drlg

Lost Spring


Ft. from N. Line

700 Ft. from S. Line

990 Ft. from E. Line

Ft. from W. Line

NW SE NE

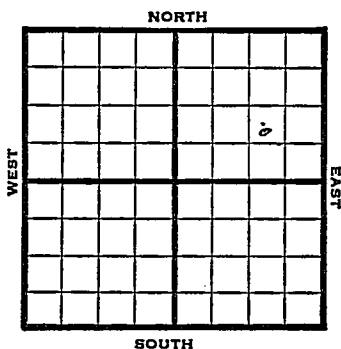

1949

Elev 1424'

R E P O R T

10/5

Location

10/12

10" @ 85

Drlg 560'

10/19

Mississippi 2292'

TD 2293'

5" @ 2293'

10/26

"

11/2

TD 2336'

Miss 2292'

5" @ 2293'

Pump 45 Oil Pot

36° Gr.

Comp

COMPLETED

Map No. _____ Sec. 34 Twp. 16 R. 4E

Well No. 7 Biehler

Hutchinson Oil & Gas Company

Slusser Drllr. Contractor

NW SE NE


FIRST REPORT
SECTION PLAT

_____ Ft. from N. Line

700 Ft. from S. Line

900 Ft. from E. Line

_____ Ft. from W. Line

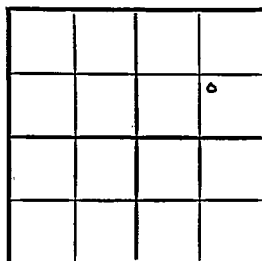

Dickinson County

Location X

Rig up

Drilling and Remarks:

RECORD

Cased _____ in., _____ ft.

Sand _____

Gas _____

Oil _____

Total Depth _____

PRODUCTION

1st 24 hrs. Nat. _____

1st 24 hrs. after shot _____

Gas _____ Cu. Ft.

Dry Hole _____

Abandoned _____

Date

OCT 5 1949 19

S. J. LEWIS Scout

Kansas

Map No. _____ Sec. 34 Twp. 16 R. 4EWell No. 7 Biehler

Hutchinson Oil & Gas _____ Company

COMPLETE

Contractor

NW SE NE

E 11424
SECTION PLAT

			0

_____ Ft. from N. Line

700 Ft. from S. Line990 Ft. from E. Line

_____ Ft. from W. Line

Dickinson County

Location _____

Rig up _____

Drilling and Remarks:

*Misc 2292**5' C 2293**Propp 45 oil RT**36 1/2 in*

RECORD

Cased _____ in., _____ ft.

Sand _____

Gas _____

Oil _____

Total Depth 2336

PRODUCTION

1st 24 hrs. Nat. _____

1st 24 hrs. after shot _____

Gas _____ Cu. Ft.

Dry Hole _____

Abandoned _____

Date

NOV 2 1949 19S. J. LEWIS Scout