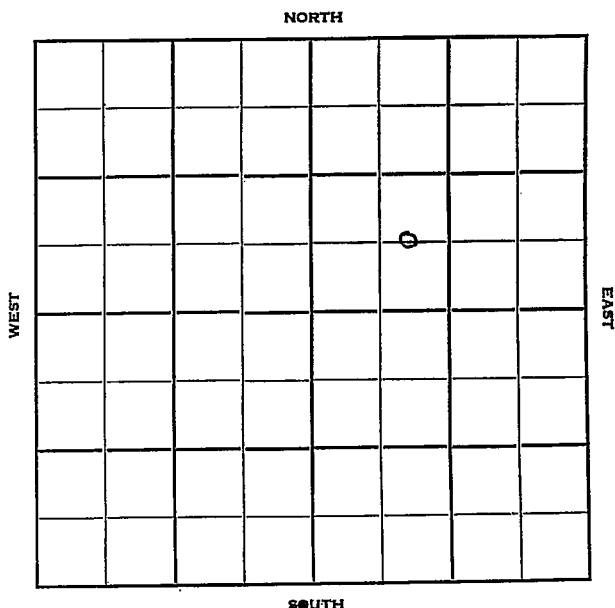


Section 34 Township 16 Range 4EWell No. 9 BiehlerCompany McPherson Oil

Dickinson

KANSAS

Sec. 34 Twp. 16 R. 4 E

Well No. # 9 Biehler Farm

McPherson Oil Company

Slusser Drlg. Contractor

Lost Spring Pool


 Ft. from N. Line

660 Ft. from S. Line

 Ft. from E. Line

990 Ft. from W. Line

C E L SW NE

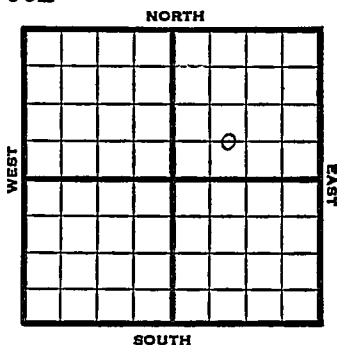

1951 Elev. - REPORT

8/1 R U R

8/15 Spud 7-31-51
Oil well TD 2335' 8" @ 110
Miss. 2285-87' TD 5 1/2" @ 2285'
DD 2335' FU 500' oil 1/2 hr.
Comp. 30 BOPD

COMPLETED



R U R

J. E. LYRA

County Dickinson State Kansas
 Sec. 34 (Blk.) 16 (Sur.) 4E (Twp.) Kansas
 Operator McPherson Oil
 Well No. 9 Farm Biehler
 Elev. _____ Location C E L S W N E

660 Ft. From S Line NE990 Ft. From W Line Quarter

1st. Report _____

Completion AUG 15 1951Remarks Lost Spring PoolSlusser Drlg. - Contr.Spudding Date 7-31-51Drlg. Data Oil well TD 23358" @ 110 Miss. 2285-87 TD 5 $\frac{1}{2}$ " @ 2285DD 2335 FU 500' oil $\frac{1}{2}$ hr.Comp. 30 bopd

J. E. TYRA