



KANSAS

Dickinson

Sec. 34 Twp. 16 R. 4-E

Well No. 8 Martin "B" Farm

Youker et al Company

Lost Spring Pool


Ft. from N. Line

330 Ft. from S. Line

330 Ft. from E. Line

Ft. from W. Line

SE NW

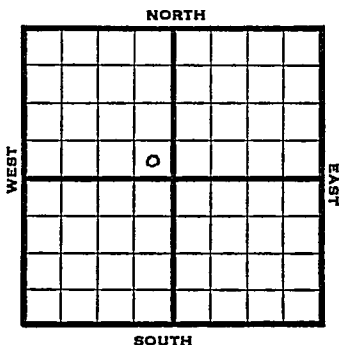

1947

Elev. 1387' REPORT

9/3 RUR

9/10 8" @ 122'  
Mississippi 2263'  
TD 2264'  
5" @ 2263  
RUST

9/17 "

9/24 "

10/1 "

10/8 "

10/15 "

10/22 Miss 2263'  
5" @ 2263'  
Pump 40 Pot  
Gr. 360  
Total Depth 2314'

**COMPLETED**

Map No. \_\_\_\_\_ Sec. 34 Twp. 16 R. 4E

Well No. 8 Martin "B"

Youker et al. Company

FIRST REPORT Contractor

SE NW

SECTION PLAT

\_\_\_\_\_ Ft. from N. Line

330 Ft. from S. Line

330 Ft. from E. Line

\_\_\_\_\_ Ft. from W. Line


Dickinson County

Location \_\_\_\_\_

Rig up \_\_\_\_\_

Drilling and Remarks: \_\_\_\_\_

R U R

RECORD

Cased \_\_\_\_\_ in., \_\_\_\_\_ ft.

Sand \_\_\_\_\_

Gas \_\_\_\_\_

Oil \_\_\_\_\_

Total Depth \_\_\_\_\_

PRODUCTION

1st 24 hrs. Nat. \_\_\_\_\_

1st 24 hrs. after shot \_\_\_\_\_

Gas \_\_\_\_\_ Cu. Ft.

Dry Hole \_\_\_\_\_

Abandoned \_\_\_\_\_

Date

SEP 3 1947 19

S. J. LEWIS Scout

