


Section 34 Township 16 Range 4EWell No. #11 Martin "B"Company Hutchinson Oil & Gas

NORTH

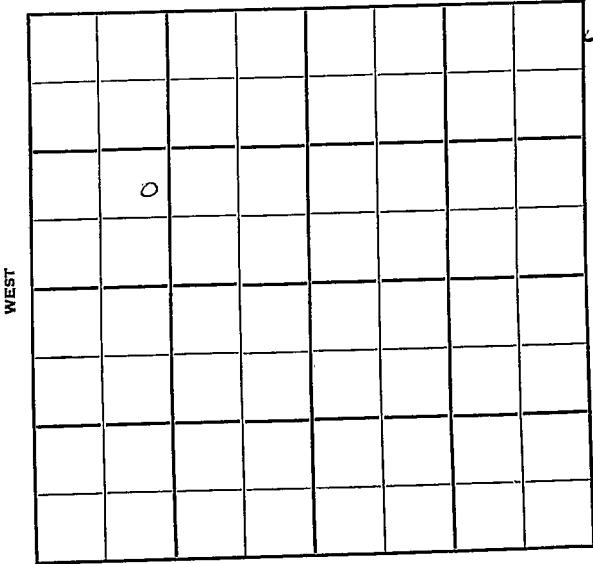

SOUTH

Sec. 34 Twp. 16 R. 4E

Well No. #11 Martin "B" Farm

Hutchinson Oil & Gas Company

Slusser Drlg. Contractor

Lost Spring Pool


1850' Ft. from N. Line

 Ft. from S. Line

 Ft. from E. Line

1150' Ft. from W. Line

NE SW NW

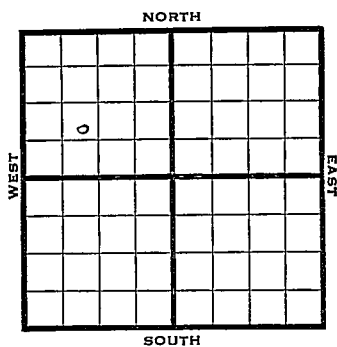

1949 Elev 1379' REPORT

11/2 8" @ 87'
Drlg. 1750'

11/9 Miss 2249'
TD

11/16 5" @ 3249'
TD 2291'

Miss 2249'
Aband.


ABANDONED

Kansas

Lost Spring Pool

Map No. _____ Sec. 34 Twp. 16 R. 4EWell No. 11 Martin "B"Hutchinson Oil & Gas CompanySlusser Drlg. Contractor

NE SW NW

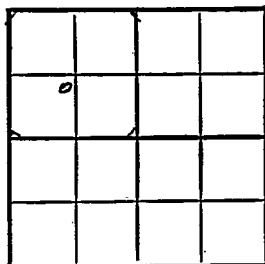FIRST REPORT
SECTION PLAT1850 Ft. from N. Line Ft. from S. Line Ft. from E. Line1150 Ft. from W. LineDickinson County

Location _____

Rig up _____

Drilling and Remarks:

8" @ 87

drlg. 1750

RECORD

Cased _____ in., _____ ft.

Sand _____

Gas _____

Oil _____

Total Depth _____

PRODUCTION

1st 24 hrs. Nat. _____

1st 24 hrs. after shot _____

Gas _____ Cu. Ft.

Dry Hole _____

Abandoned _____

Date

NOV 2 1949

19

S. J. LEWIS

Scout

Kansas

Lost Spring Pool

Map No. _____ Sec. 34 Twp. 16 R. 4EWell No. 11 Martin "B"

Hutchinson Oil & Gas Company

ABANDONED


Contractor

NE SW NW

E1.1379
SECTION PLAT1850 Ft. from N. Line

_____ Ft. from S. Line

_____ Ft. from E. Line

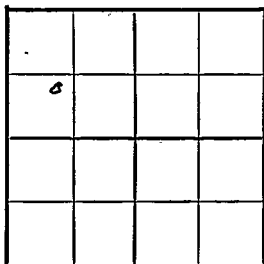1150 Ft. from W. Line

Dickinson County

Location _____

Rig up _____

Drilling and Remarks:

Miss 2249

RECORD

Cased _____ in., _____ ft.

Sand _____

Gas _____

Oil _____

Total Depth 2291

PRODUCTION

1st 24 hrs. Nat. _____

1st 24 hrs. after shot _____

Gas _____ Cu. Ft.

Dry Hole _____

Abandoned _____

Date

NOV 16 1949S. J. LEWIS

Scout