


Dickinson County

FORM 51 IOM 12-46 RETROE KANSAS

Section 34 Township 16 Range 4-E

Well No. #6 Martin "B"

Company B. Youker
Lost Spring

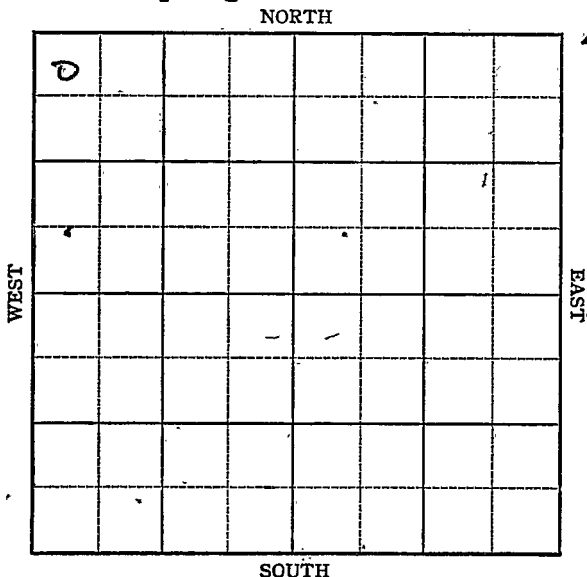



Sec. 34 Twp. 16 R. 4-E

Well No. #6 Martin "B" Farm

B. Youker Company

Lost Spring


330 Ft. from N. Line

_____ Ft. from S. Line

_____ Ft. from E. Line

330 Ft. from W. Line

NW/c

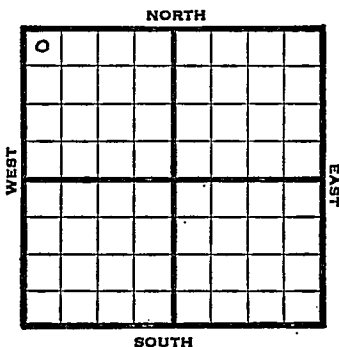

1947 Elev. 1390' REPORT

6/18 Location

6/24 "

7/1 "

7/8 "

7-16 "

7/22 Spud

7/29 "

8/6 8" @ 160'
Miss. 2282'
5" @ 2282'
TD 2346'

8/13 3000 acid

8/20 " "

8/27 " "

9/3 Miss. 2282'
5" @ 2282'
3000 Acid
Pump 30 Pot
38.0 Gr.
TD 2346'

COMPLETED

Map No. _____ Sec. 34 Twp. 16 R. 4E

Well No. 6 Martin "B"

B. Youker _____ Company

FIRST REPORT _____ Contractor

NW/C

SECTION PLAT

330 Ft. from N. Line

_____ Ft. from S. Line

_____ Ft. from E. Line

330 Ft. from W. Line

o			

Dickinson County

Location X

Rig up _____

Drilling and Remarks:

RECORD

Cased _____ in., _____ ft.

Sand _____

Gas _____

Oil _____

Total Depth _____

PRODUCTION

1st 24 hrs. Nat. _____

1st 24 hrs. after shot _____

Gas _____ Cu. Ft.

Dry Hole _____

Abandoned _____

Date

JUN 18 1947 19 _____ S. I. LEWIS Scout

